


Woodson

Form 51-5M-11-31-Palace

Map No. KANSAS Sec. 31 Twp. 23 R. 14^E

Well No. 8 - Shaffer Farm

Sheta Oil Co Company

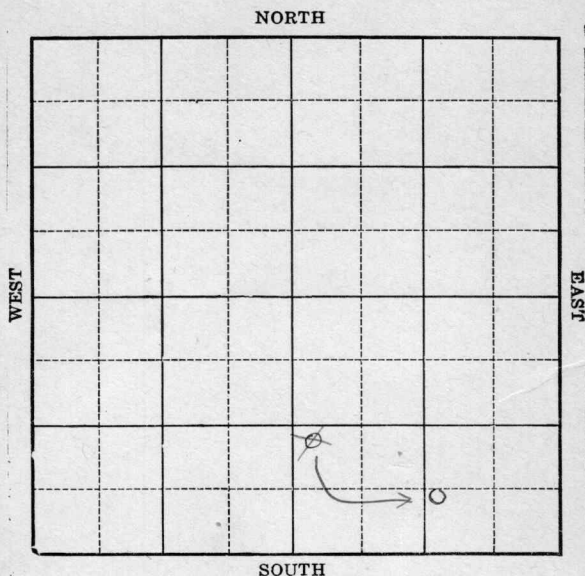

Location

Drilling Remarks

Rig Up

Drilling Remarks

RECORD

Cased in. ft.

Sand

Gas

Oil

Total Depth

PRODUCTION

1st 24 hrs. Nat.

1st 24 hrs. after shot

Gas cu. ft.

Dry Hole

Abandoned

Map No. KANSAS Sec. 5 Twp. 23 R. 14


Well No. 8-2242 Farm

Company

 Ft. from S. Line

200 Ft. from W. Line

1932

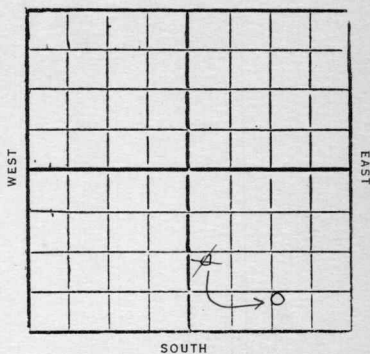

SOUTH

REPORT

8/10 Loc
8/17
8/24 Rgn up mach
8/31 12th 33
dreg 325'
9/7 " 1000'
9/14 6"-1550
Top sand 1550
dreg 1560 sand
9/21 sand 1550-60 dry
Top lime 1699
TD. 1758 HFW
Dry & abandon

17 KANSAS

Map No. _____ Sec. 31 Twp. 23 R. 14

Well No. 8 Shaffer

Thera Oil Co

Company

Contractor

FIRST REPORTS

Ft. from N. Line

1710 Ft. from S. Line

Ft. from E. Line

800 Ft. from W. Line

SECTION PLAT

Location ✓

Rig up

Drilling and Remarks:

RECORD

Cased _____ in., _____ ft.

Sand _____

Gas _____

Oil _____

Total Depth _____

PRODUCTION

1st 24 hrs. Nat. _____

1st 24 hrs. after shot _____

Gas _____ Cu. Ft.

Dry Hole _____

Abandoned _____

Date

AUG 10 1932

192

CHAS. L. SHERWOOD

Scout

Noodson

17 KANSAS Sec. 31 Twp. 73 R. 14 E

 Well No. 8 Shapper
 Theta Oil Co

Company

Contractor

CORRECTION


Ft. from N. Line

650 Ft. from S. Line

Ft. from E. Line

1360 Ft. from W. Line

SECTION PLAT

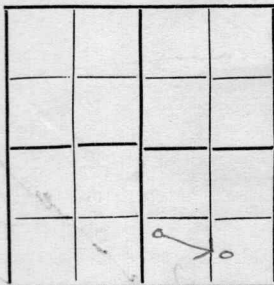

Location

Rig up

Drilling and Remarks:

 Change location
 to above

RECORD

Cased in, ft.

Sand

Gas

Oil

Total Depth

PRODUCTION

1st 24 hrs. Nat.

1st 24 hrs. after shot

Gas Cu. Ft.

Dry Hole

Abandoned

Date

AUG 24 1932 CHAS. L. SHERWOOD

192

Scout

17 **KANSAS** Map No. Sec. 31 Twp. 23 R. 14

Well No. 8 Shapper

Therrell Co Company

Contractor

COMPLETED

SECTION PLAT

Ft. from N. Line

650 Ft. from S. Line

Ft. from E. Line

1360 Ft. from W. Line

ABANDONED

Location

Rig up

Drilling and Remarks:

Land 1550-60 Dry.

Top line 1699

DT 4 1758

HFW

RECORD

Cased in., ft.

Sand

Gas

Oil

Total Depth 1758

PRODUCTION

1st 24 hrs. Nat.

1st 24 hrs. after shot

Gas Cu. Ft.

Dry Hole ✓

Abandoned ✓

Date

SEP 2 1 1932 CHAS. L. SHERWOOD

192

Scout