


Map No. K Sec. 14 Twp. 24 R. 9 ✓
 Well No. 2 Agard Farm
Mission Oil Company

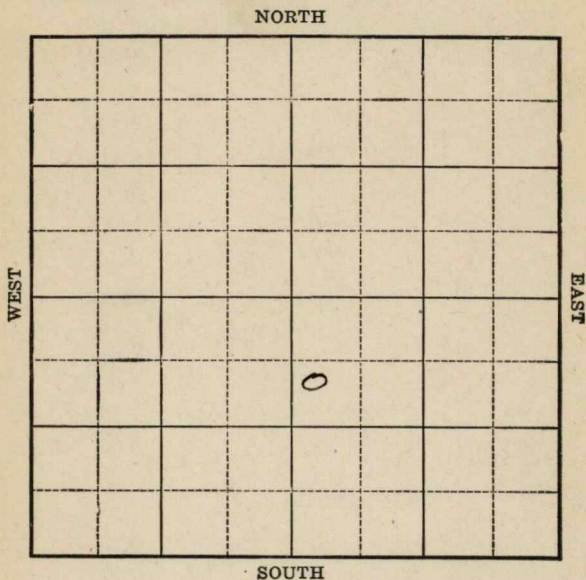

Location _____

Drilling Remarks:

RECORD

Cased _____ in. _____ ft.
 Sand _____
 Gas _____
 Oil _____
 Total Depth _____

Rig Up _____

Drilling Remarks:

PRODUCTION

1st 24 hrs. Nat. _____
 1st 24 hrs. after shot _____
 Gas _____ cu. ft.
 Dry Hole _____
 Abandoned _____

Map No. **KANSAS** 15 Sec. 14 Twp. 24 R. 9
 Well No. #2 Agard.
 Mission Oil Company

Contractor

FIRST REPORT

SECTION PLAT

760 Ft. from N. Line

Ft. from S. Line

Ft. from E. Line

200 Ft. from W. Line

		0	

Location

Rig up ✓✓

Drilling and Remarks:

RECORD

Cased _____ in., _____ ft.

Sand _____

Gas _____

Oil _____

Total Depth _____

PRODUCTION

1st 24 hrs. Nat. _____

1st 24 hrs. after shot _____

Gas _____ Cu. Ft.

Dry Hole _____

Abandoned _____

Date

MAR 14 1924

M. A. BENEAR

192

Scout

Map No. **KANSAS** 15 Sec. **14** Twp. **24** R. **9**Well No. **#2 Ogard****Mission** Company

Contractor

ABANDONED SECTION PLAT**760'** Ft. from N. Line

Ft. from S. Line

Ft. from E. Line

200' Ft. from W. Line

		0	

Location

Rig up

Drilling and Remarks:

No sand**20 x 9****2260'****RECORD**

Cased _____ in., _____ ft.

Sand _____

Gas _____

Oil _____

Total Depth _____

PRODUCTION

1st 24 hrs. Nat. _____

1st 24 hrs. after shot _____

Gas _____ Cu. Ft.

Dry Hole _____

Abandoned _____

Date

APR 23 1924**M. A. BENEAR****192**

Scout