


Section 31 Township 23 Range 14-E


Well No. 6 Shaffer

Company Nye & Kilby

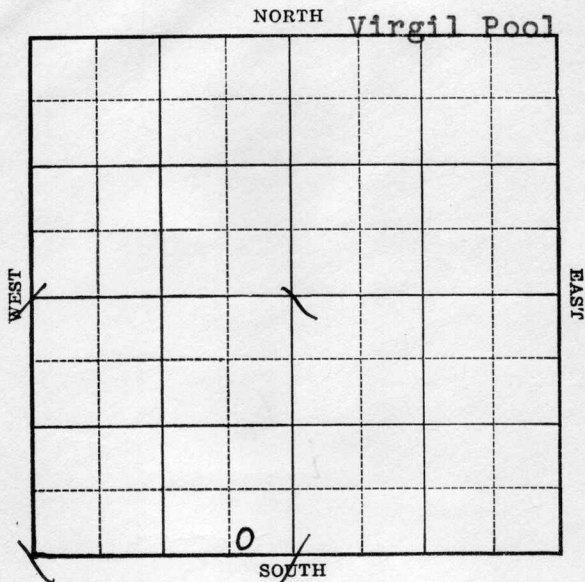

KANSAS

Woodson

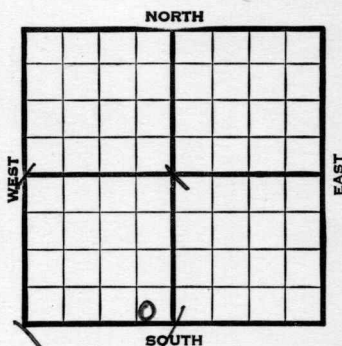Sec. 31 Twp. 23 R. 14-EWell No. #6 Shaffer FarmNye & Kilby Company
(Virgil) Ft. from N. Line440 Ft. from S. Line235 Ft. from E. Line Ft. from W. Line

1939

REPORT

5/17 Drlg. 635'

5/26 10" - 854' Drlg. 1225'

6/7 Bart. and 8" - 1535'

Pay 1562-64' 600' oil 48 hrs.

6/7 Bart. 1535 8" 1535

T.D. 1564

Shot 10 qts.

20 bbls. pump

COMPLETED

Map No. 17 Sec. 31 Twp. 23 R. 14EWell No. 6 ShafferNye & Kilby

Company

Contractor

FIRST REPORT
C S L SE SW

SECTION PLAT

 Ft. from N. Line440 Ft. from S. Line235 Ft. from E. Line Ft. from W. Line

VIRGIL POOL

Location Rig up

Drilling and Remarks:

Drlg. 635

RECORD

Cased in., ft.Sand Gas Oil Total Depth

PRODUCTION

1st 24 hrs. Nat. 1st 24 hrs. after shot Gas Cu. Ft.Dry Hole Abandoned

Date

MAY 17 1939

19

S. J. LEWIS

Scout

Woodson

Map No. 17 Sec. 31 Twp. 23 R. 14EWell No. 6 ShafferNye & Kilby

Company

Contractor

COMPLETED

C S L SE SW

Ft. from N. Line

440

Ft. from S. Line

235

Ft. from E. Line

Ft. from W. Line

VIRGIL POOL

SECTION PLAT

Location _____

RECORD

Cased _____ in., _____ ft.

Sand _____

Gas _____

Oil _____

Total Depth 1564

PRODUCTION

1st 24 hrs. Nat. _____

1st 24 hrs. after shot _____

Gas _____ Cu. Ft.

Dry Hole _____

Abandoned _____

Rig up _____

Drilling and Remarks:

Bar 8 15358" C 1535Shot 109 to20 44kPump

Date

JUN 7 1939

19

S. J. LEWIS

Scout