


Map No. N. 15 Sec. 14 Twp. 24 R. 9

Well No. 1 Agard Farm  
Baseline Ethal Company

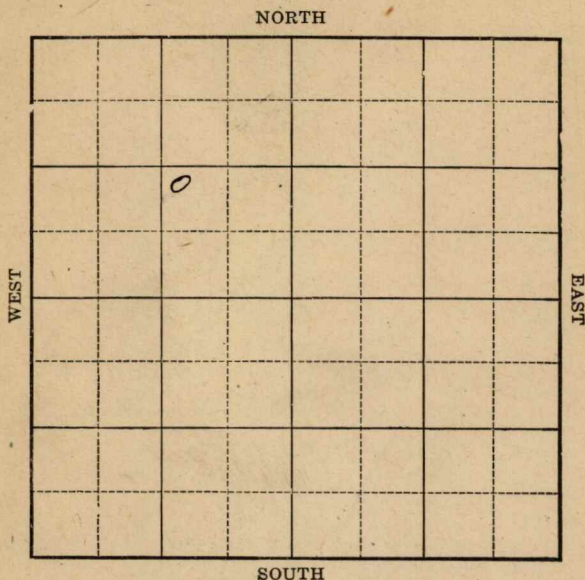

Location \_\_\_\_\_

Drilling Remarks:

\_\_\_\_\_  
 \_\_\_\_\_  
RECORD

Cased \_\_\_\_\_ in. \_\_\_\_\_ ft.  
 Sand \_\_\_\_\_  
 Gas \_\_\_\_\_  
 Oil \_\_\_\_\_  
 Total Depth \_\_\_\_\_

Rig Up \_\_\_\_\_

Drilling Remarks:

\_\_\_\_\_  
 \_\_\_\_\_  
PRODUCTION

1st 24 hrs. Nat. \_\_\_\_\_  
 1st 24 hrs. after shot \_\_\_\_\_  
 Gas \_\_\_\_\_ cu. ft.  
 Dry Hole \_\_\_\_\_  
 Abandoned \_\_\_\_\_



Map No. **KANSAS** 15 Sec. 14 Twp. 24 R. 9

Well No. 1 Agard

Bashner et al Company

Contractor

**FIRST REPORT****SECTION PLAT**

Ft. from N. Line

1120 Ft. from S. Line

1120 Ft. from E. Line

Ft. from W. Line

|  |     |  |  |
|--|-----|--|--|
|  |     |  |  |
|  | 10. |  |  |
|  |     |  |  |
|  |     |  |  |

Location

Rig up

Drilling and Remarks:

S.D. 1260

**RECORD**

Cased in., ft.

Sand

Gas

Oil

Total Depth

**PRODUCTION**

1st 24 hrs. Nat.

1st 24 hrs. after shot

Gas Cu. Ft.

Dry Hole

Abandoned

Date

NOV 3 1923

M A BENEAR

192

Scout

Map No. **KANSAS** 15 Sec. **14** Twp. **24** R. **9**

Well No. **#1 Guard**

**Basum et al** Company

**Taken over by McGinnis et al.** Contractor

**COMPLETED**

**SECTION PLAT**

|  |   |  |  |
|--|---|--|--|
|  |   |  |  |
|  | 0 |  |  |
|  |   |  |  |
|  |   |  |  |
|  |   |  |  |

----- Ft. from N. Line

**1120** Ft. from S. Line

**1120** Ft. from E. Line

----- Ft. from W. Line

Location -----

Rig up -----

Drilling and Remarks:

**sand 2134-2169**

**shot 90/200 bbls**  
**pumping**

**RECORD**

Cased ----- in., ----- ft.

Sand -----

Gas -----

Oil -----

Total Depth -----

**PRODUCTION**

1st 24 hrs. Nat. -----

1st 24 hrs. after shot -----

Gas ----- Cu. Ft.

Dry Hole -----

Abandoned -----

Date

**JAN 18 1924**

192

**M. A. BENEAR**

Scout