


Map No. _____ Sec. 14 Twp. 24 R. 9 ✓
 Well No. 3 Agard Farm _____
Mc Ginnis Company _____

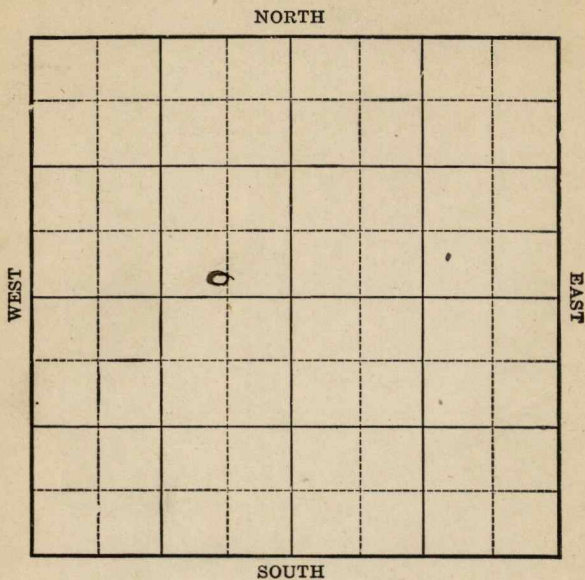

Location _____

Drilling Remarks:

Rig Up _____

Drilling Remarks:

RECORD

Cased _____ in. _____ ft.

Sand _____

Gas _____

Oil _____

Total Depth _____

PRODUCTION

1st 24 hrs. Nat. _____

1st 24 hrs. after shot _____

Gas _____ cu. ft.

Dry Hole _____


Abandoned _____

Map No. K Sec. 14 Twp. 24 R. 9Well No. 3 Agard Farm
M. C. Dennis Company

Ft. from N. Line

200 Ft. from S. Line

Ft. from E. Line

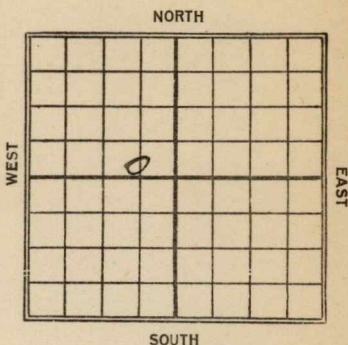660 Ft. from W. Line

REPORT

Date

19241/15 Boq2/19 Sand 2100-2170'Shot 155/150 Bobs

Map No. **KANSAS** Sec. **14** Twp. **24** R. **9**Well No. **3 Agard**
McGinnis Company

Contractor

FIRST REPORT

SECTION PLAT

----- Ft. from N. Line

200 ----- Ft. from S. Line

----- Ft. from E. Line

660 ----- Ft. from W. Line

	o		

Location -----

Rig up -----

Drilling and Remarks:

R.O. G. 1/14/24

RECORD

Cased ----- in., ----- ft.

Sand -----

Gas -----

Oil -----

Total Depth -----

PRODUCTION

1st 24 hrs. Nat. -----

1st 24 hrs. after shot -----

Gas ----- Cu. Ft.

Dry Hole -----

Abandoned -----

Date

JAN 15 1924**M. A. BENEAR**

191

Score

Map No. KANSAS 15 14 Sec. 24 Twp. 9 R. 9

Well No. 3 Agard
McGinnis et al Company

Contractor

COMPLETED

SECTION PLAT

_____ Ft. from N. Line

200 Ft. from S. Line

660 Ft. from E. Line

_____ Ft. from W. Line

Location _____

Rig up _____

Drilling and Remarks:

sand 2100-2170

155/150 Rbl

RECORD

Cased _____ in., _____ ft.

Sand _____

Gas _____

Oil _____

Total Depth _____

PRODUCTION

1st 24 hrs. Nat. _____

1st 24 hrs. after shot _____

Gas _____ Cu. Ft.

Dry Hole _____

Abandoned _____

Date

FEB 19 1924

M. A. BENEAR

192

Scout