


Map No. _____ Sec. 14 Twp. 24 R. 9
 Well No. 4 Bratton Farm _____
Rogers et al Company _____

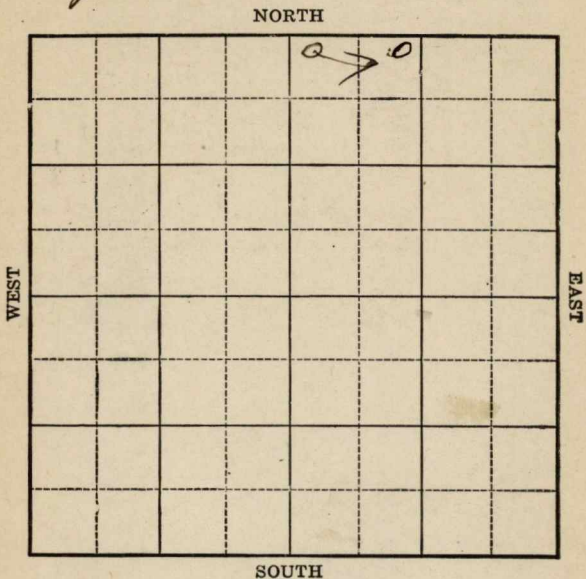

Location _____

Drilling Remarks:

Rig Up _____

Drilling Remarks:

RECORD

Cased _____ in. _____ ft.
 Sand _____
 Gas _____
 Oil _____
 Total Depth _____

PRODUCTION

1st 24 hrs. Nat. _____
 1st 24 hrs. after shot _____
 Gas _____ cu. ft.
 Dry Hole _____
 Abandoned _____

Map No. K Sec. 14 Twp. 24 R. 9

Well No. 4 Bratton Farm


Rogers Et al Company

200 Ft. from N. Line

_____ Ft. from S. Line

_____ Ft. from E. Line

200 Ft. from W. Line

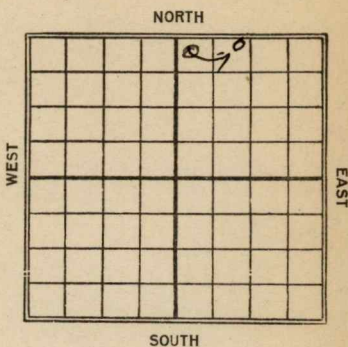

Date 1924

REPORT

11/15	Location
-------	----------

4/2 2089-2189

720 220 4

Two / 50 Bells

Map No. **KANSAS** Sec. **14** Twp. **24** R. **9**Well No. **4 Bratton**
Rogers et al Company

Contractor

FIRST REPORT

SECTION PLAT

200 Ft. from N. Line

Ft. from S. Line

Ft. from E. Line

200 Ft. from W. Line

		0	

Location **✓✓**

Rig up

Drilling and Remarks:

RECORD

Cased _____ in., _____ ft.

Sand _____

Gas _____

Oil _____

Total Depth _____

PRODUCTION

1st 24 hrs. Nat. _____

1st 24 hrs. after shot _____

Gas _____ Cu. Ft.

Dry Hole _____

Abandoned _____


Date

JAN 15 1924

M. A. BENEAR

Map No. **KANSAS** ¹⁵ Sec. **14** Twp. **24** R. **9**Well No. **#4 Bratton** FarmCompany **Royers et al****200 from N NORTH 1120 from W**

WEST

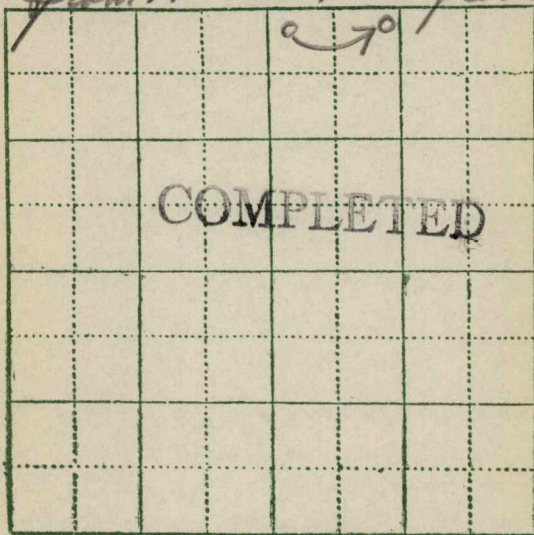

EAST

SOUTH

Location -----

Rig up -----

Drilling and Remarks:

and 2079-2189**J.D. 2204****200/50 HWS**

RECORD

Cased ----- in., ----- ft.

Sand -----

Gas -----

Oil -----

Total Depth -----

PRODUCTION

1st 24 hrs. Nat. -----

1st 24 hrs. after shot -----

Gas ----- Cu. Ft.

Dry Hole -----

Abandoned -----

Date

APR 2**1924****M. A. BENEAR****192**

Scout