


Woodson

Form 51-5M-2-29-34703

Map No. KANSAS Sec. 32 Twp. 23 R. 14

Well No. R. G. Dewey Farm
J. L. Gillespie Company

NORTH

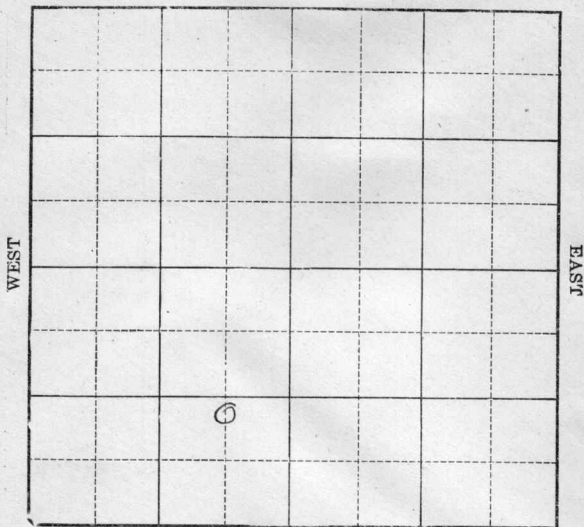

SOUTH

Location

Drilling Remarks

Rig Up

Drilling Remarks

RECORD

Cased in. ft.

Sand

Gas

Oil

Total Depth

PRODUCTION

1st 24 hrs. Nat.

1st 24 hrs. after shot

Gas cu. ft.

Dry Hole

Abandoned

Map No. *Kns* Sec. *32* Twp. *23* R. *14*

Well No. *10* *Dewey*
B.S. Sillespie Company

Contractor

FIRST REPORTS

COMPLETED

SECTION PLAT

Ft. from N. Line

Ft. from S. Line

Ft. from E. Line

Ft. from W. Line

Location

Rig up

Drilling and Remarks:

1/2 AT gas.

No Depth

RECORD

Cased.....in.,ft.

Sand.....

Gas.....

Oil.....

Total Depth.....

PRODUCTION

1st 24 hrs. Nat.....

1st 24 hrs. after shot.....

Gas.....Cu. Ft.

Dry Hole.....

Abandoned.....

Date

3/18/22

192

Sherwood

Scout