


Form 51-5M-2-29-34703

Woodson

Map No. KANSAS Sec. 32 Twp. 23 R. 14

Well No. R. 93-2 Brewery Farm

R. J. Gillespie Company

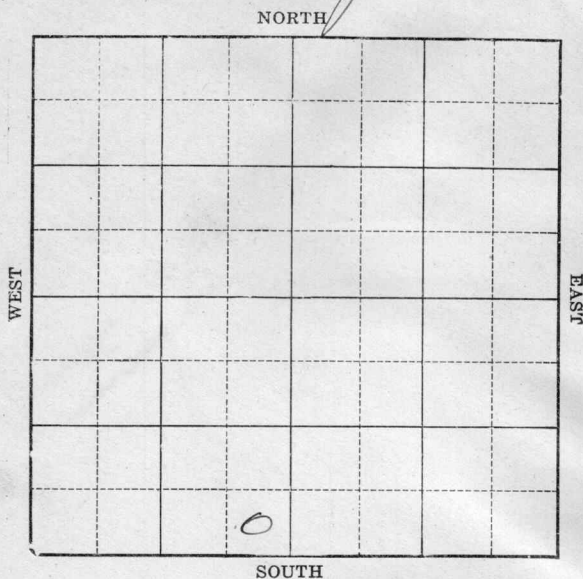

Location _____

Drilling Remarks _____

Rig Up _____

Drilling Remarks _____

RECORD

Cased _____ in. _____ ft.

Sand _____

Gas _____

Oil _____

Total Depth _____

PRODUCTION

1st 24 hrs. Nat. _____

1st 24 hrs. after shot _____

Gas _____ cu. ft.

Dry Hole _____

Abandoned _____

Map No. _____ Sec. 32 Twp. 83 R. 14

Well No. 3 Dewey

H. S. Gillespie Company

Contractor

FIRST REPORTS COMPLETED

SECTION PLAT

_____ Ft. from N. Line

700 Ft. from S. Line

700 Ft. from E. Line

_____ Ft. from W. Line

Location _____

Rig up _____

Drilling and Remarks:

30/35 Bls.

RECORD

Cased _____ in. _____ ft.

Sand 1670-1692

Gas _____

Oil _____

Total Depth 1692

PRODUCTION

1st 24 hrs. Nat. _____

1st 24 hrs. after shot _____

Gas _____ Cu. Ft.

Dry Hole _____

Abandoned _____

Date

_____ 192 _____

Sherwood

Scout