

Map No. 1 Sec. 17 Twp. 24 R. 7

Well No. 3 Hellman Farm

Miller & Hal Company

NORTH

WEST

EAST

SOUTH

Location _____

Drilling Remarks:

Rig Up _____

Drilling Remarks:

RECORD

Cased _____ in. _____ ft.

Sand _____

Gas _____

Oil _____

Total Depth _____

PRODUCTION

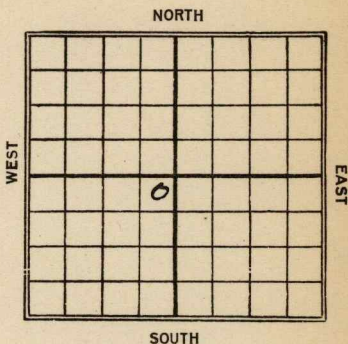
1st 24 hrs. Nat. _____

1st 24 hrs. after shot

Gas _____ cu. ft.

Dry Hole _____

Abandoned_____

Map No. K Sec. 14 Twp. 24 R. 9Well No. 3 Hillman Farm
Miller et. al Company150 Ft. from N. Line Ft. from S. Line150 Ft. from E. Line Ft. from W. Line

REPORT

~~1/1/24~~

2/27 Location
 4/2 2090-2192
 200/000 Bbls

Map No. **KANSAS** 15 Sec. 14 Twp. 24 R. 9Well No. 3 Hellman
Miller et al Company

Contractor

FIRST REPORT SECTION PLAT

150 Ft. from N. Line

Ft. from S. Line

150 Ft. from E. Line

Ft. from W. Line

Location ✓✓

Rig up

Drilling and Remarks:

RECORD

Cased _____ in., _____ ft.

Sand _____

Gas _____

Oil _____

Total Depth _____

PRODUCTION

1st 24 hrs. Nat. _____

1st 24 hrs. after shot _____

Gas _____ Cu. Ft.

Dry Hole _____

Abandoned _____

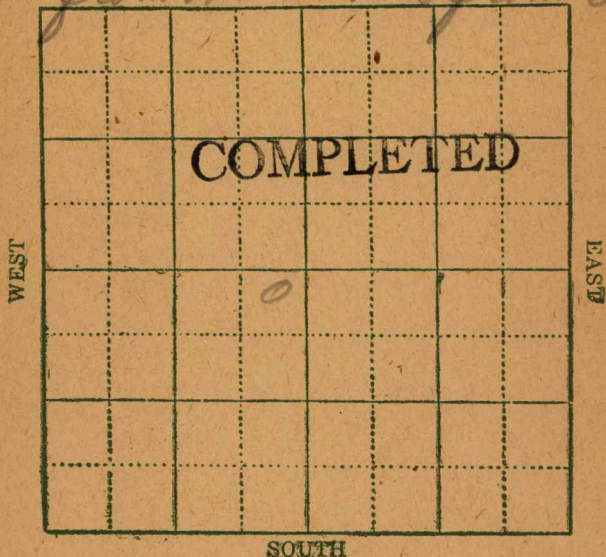
Date

FEB 27 1924

192

M. A. BENEAR

Scout

Map No. **KANSAS** Sec. *15* Twp. *34* R. *9*Well No. *3 Hillman* Farm*Miller et al.* Company*150 from N* NORTH *150 from E*

Location -----

Rig up -----

Drilling and Remarks:

*2090-2192**200/200 Hbl*

RECORD

Cased ----- in., ----- ft.

Sand -----

Gas -----

Oil -----

Total Depth -----

PRODUCTION

1st 24 hrs. Nat. -----

1st 24 hrs. after shot -----

Gas ----- Cu. Ft.

Dry Hole -----

Abandoned -----

Date
APR 2 1924

M. A. BENEAR

192

Scout