

Greenwood


**KANSAS**  
24

✓  
9E

Section 14 Township \_\_\_\_\_ Range \_\_\_\_\_


Well No. #1 Olson

Company Ward McGinnis

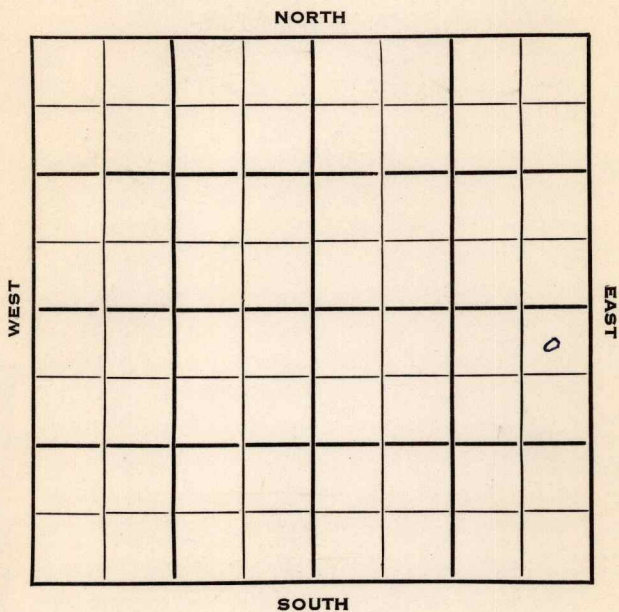

Greenwood **KANSAS** ✓Sec. 14 Twp. 24 R. 9 EWell No. # 1 Olson FarmWard McGinnis CompanyWard McGinnis Contractor330 Ft. from N. Line         Ft. from S. Line330 Ft. from E. Line         Ft. from W. Line

NE NE SE

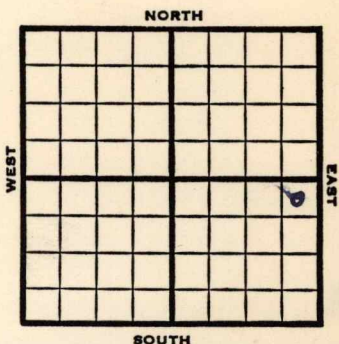1953 **Elev. -**

REPORT

2/11 RUR

3/4 Spud 2-13-53

Oil Well

TD 2475

8" @ 100

**Bart 2260, Miss 2380**

TD 2475

5" @ 2270

PB 2272 sd-frac

Comp. 15 bopd

**COMPLETED**

|          |               |                 |               |                        |        |         |
|----------|---------------|-----------------|---------------|------------------------|--------|---------|
| County   | Greenwood     |                 | State         | Kansas                 |        |         |
| Sec.     | 14            | (Blk.)<br>Twp.) | 24            | (Sur.)<br>Rge.)        | 9E     |         |
| Operator | Ward McGinnis |                 |               |                        |        |         |
| Well No. | 1             | Farm            | Olson         |                        |        |         |
| Elev.    |               |                 | Location      | NE NE SE               |        |         |
|          |               |                 | 330           | Ft. From               | N Line | SE      |
|          |               |                 | 330           | Ft. From               | E Line | Quarter |
|          |               |                 | 1st. Report   | FEB 11 1953            |        |         |
|          |               |                 | Completion    |                        |        |         |
|          |               |                 | Remarks       | Ward McGinnis - Contr. |        |         |
|          |               |                 | Spudding Date |                        |        |         |

Drlg. Data

R U R

[illegible]

J. G. McGEHEE