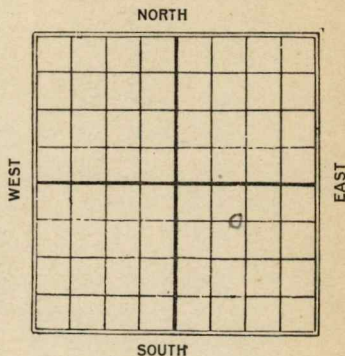


Map No. Kansas Sec. 11 Twp. 24 R 9Well No. 12 Oalson FarmTrans. Company660 Ft. from N. Line

Ft. from S. Line

Ft. from E. Line

1120 Ft. from W. Line

Date

REPORT

19253/24 Rig up4/17 \$ 2158-98 140 gts150 bbls

Map No. **KANSAS** Sec. 11 Twp. 24 R. 9Well No. 12 Olson
Transcontinental Company

Contractor

FIRST REPORT

SECTION PLAT

660 Ft. from N. Line

_____ Ft. from S. Line

_____ Ft. from E. Line

1120 Ft. from W. Line

Location _____

Rig up ✓✓

Drilling and Remarks:

RECORD

Cased _____ in., _____ ft.

Sand _____

Gas _____

Oil _____

Total Depth _____

PRODUCTION

1st 24 hrs. Nat. _____

1st 24 hrs. after shot _____

Gas _____ Cu. Ft.

Dry Hole _____

Abandoned _____

Date

3/24 1923

M. A. BENEAR

Scout

Map No. 15 Lands Sec. 4 Twp. 24 R. 9

Well No. 12 Olden
Mans Contracted also Company

Contractor

COMPLETED

SECTION PLAT

660 Ft. from N. Line

----- Ft. from S. Line

----- Ft. from E. Line

1120 Ft. from W. Line

Location -----

Rig up -----

Drilling and Remarks:

Tap And 2158-98

144 150 bbls

RECORD

Cased ----- in., ----- ft.

Sand -----

Gas -----

Oil -----

Total Depth -----

PRODUCTION

1st 24 hrs. Nat. -----

1st 24 hrs. after shot -----

Gas ----- Cu. Ft.

Dry Hole -----

Abandoned -----

Date

APR 17 1925

192

Chas. L. Shewood
 Scout