


Woodson

Form 51-5M-2-29-34703

Map No. KANSAS Sec. 32 Twp. 23 R. 14

Well No. 16 - Headley Farm
Jones - Oeh Company

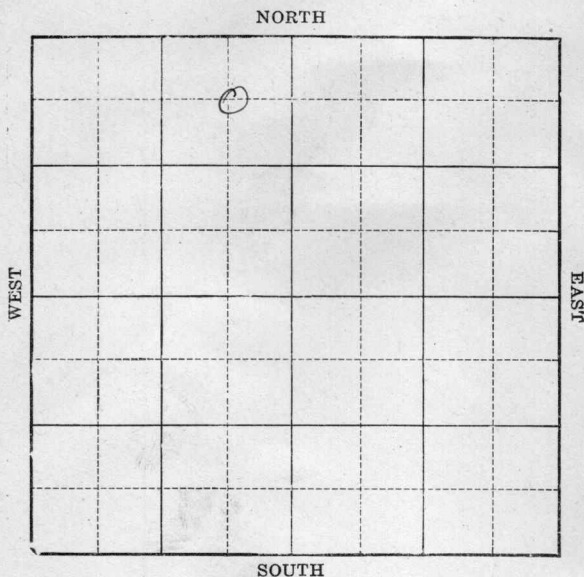

Location

Drilling Remarks

Rig Up

Drilling Remarks

RECORD

Cased in. ft.

Sand

Gas

Oil

Total Depth

PRODUCTION

1st 24 hrs. Nat.

1st 24 hrs. after shot


Gas cu. ft.

Dry Hole

Abandoned

State _____ County Woodson
Sec. 32 Twp. 23 N-S; Rge. 14 E-W
Well No. 16 Headley Farm _____
Jones-Och Company _____

NORTH

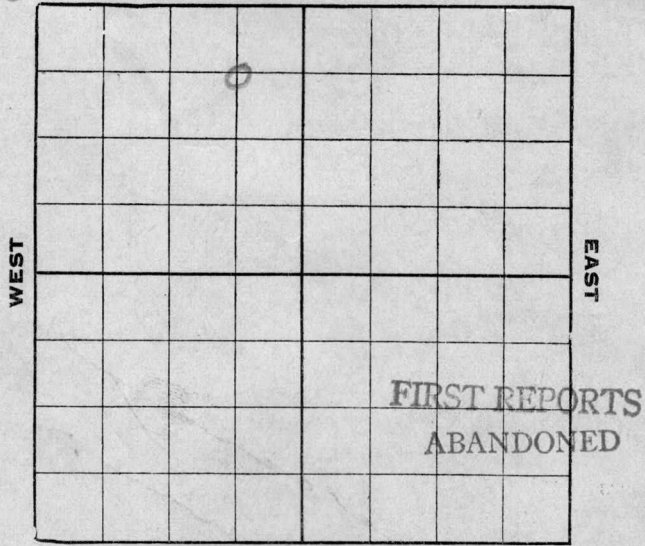

SOUTH

Location _____ Cased _____ in. _____ ft.
Rig up _____ Mach _____ Productive Horizons
From _____ To _____
Drilling at _____
Fishing at _____
U. R. to _____
S. D. at _____
Natural production _____ Bbls. per _____ hours
Pumping _____ Gas _____ Cu. ft. per 24 hours
Gauge press. _____ lbs. Total depth _____
Were samples collected _____
Remarks: 099 1727

5/7/23 Sherwood
S. C. 9-1M-11-19. 29023 Scout _____
(Over)