

WEST

EAST

SOUTH

0

Drilling Remarks:

Drilling Remarks:

Cased _____ in. _____ ft.
 Sand _____
 Gas _____
 Oil _____
 Total Depth _____


1st 24 hrs. Nat. _____
1st 24 hrs. after shot _____
Gas _____ cu. ft.
Dry Hole _____
Abandoned _____

Map No. K Sec. 11 Twp. 24 R. 9Well No. 9 Calson Farm
Transcontinental Company200 Ft. from N. Line

Ft. from S. Line

1120 Ft. from E. Line

Ft. from W. Line

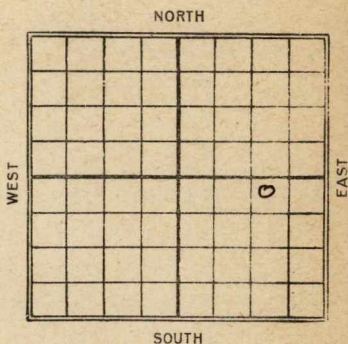

Date

REPORT

1924

3/14 Reg up

4/24 Sand 2244-89 T.D. 2295'

Shooting 180 gts

5/22 2244-89

74. 2295

180/100 Bbls

Map No. **KANSAS** Sec. 11 Twp. 24 R. 9Well No. 9 OalsonTrans Continental Company

Contractor

FIRST REPORT**SECTION PLAT**200 Ft. from N. Line

Ft. from S. Line

1120 Ft. from E. Line

Ft. from W. Line

Location

Rig up ✓✓

Drilling and Remarks:

RECORD

Cased _____ in., _____ ft.

Sand _____

Gas _____

Oil _____

Total Depth _____

PRODUCTION

1st 24 hrs. Nat. _____

1st 24 hrs. after shot _____

Gas _____ Cu. Ft.

Dry Hole _____

Abandoned _____

Date

M. A. BENEAR**MAR 14 1924**

_____ 192 _____ Scout

15 KANSAS Map No. Sec. 11 Twp. 24 R. 9

Well No. 9 O alson
Transcontinental Company

Contractor

COMPLETED SECTION PLAT

200 Ft. from N. Line

_____ Ft. from S. Line

1120 Ft. from E. Line

_____ Ft. from W. Line

			0

Location _____

Rig up _____

Drilling and Remarks:

sand-2244-89

J.D. 2295

180/100

RECORD

Cased _____ in., _____ ft.

Sand _____

Gas _____

Oil _____

Total Depth _____

PRODUCTION

1st 24 hrs. Nat. _____

1st 24 hrs. after shot _____

Gas _____ Cu. Ft.

Dry Hole _____

Abandoned _____

Date

MAY 22 1924

M. A. BENEAR

192

Scout