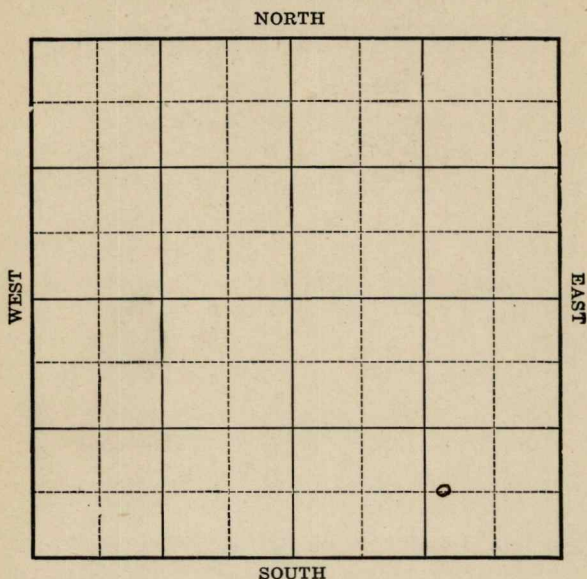


Map No. Kans Sec. 11 Twp. 24 R. 9Well No. 14 Oalson Farm
Trans Continental Company

Location _____

Drilling Remarks _____

Rig Up _____

Drilling Remarks _____

RECORD

Cased _____ in. _____ ft.

Sand _____

Gas _____

Oil _____

Total Depth _____

PRODUCTION

1st 24 hrs. Nat. _____

1st. 24 hrs. after shot _____

Gas _____ cu. ft.

Dry Hole _____

Abandoned _____

Map No. Kansas Sec. 11 Twp. 24 R. 9


Well No. 14 Oalson Farm
Trans Company

_____ Ft. from N. Line

760 Ft. from S. Line

1120 Ft. from E. Line

_____ Ft. from W. Line

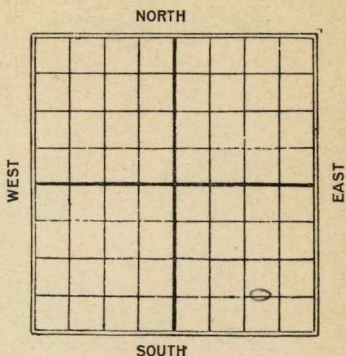

C

Date

REPORT

1925

3/24 Rig up

5/24 T.S. 2155-2190 shot @ 20 ft 600' oil
in hole.

6/5 2155-2190 T.D. - 20/30 b/s.

15
 Map No. **KANSAS** Sec. 11 Twp. 24 R. 9

 Well No. 14 *Oalson*
Transcontinental Company

Contractor

FIRST REPORT

SECTION PLAT

Ft. from N. Line

760' Ft. from S. Line

1120' Ft. from E. Line

Ft. from W. Line

Location

Rig up ✓✓

Drilling and Remarks:

RECORD

Cased _____ in., _____ ft.

Sand _____

Gas _____

Oil _____

Total Depth _____

PRODUCTION

1st 24 hrs. Nat. _____

1st 24 hrs. after shot _____

Gas _____ Cu. Ft.

Dry Hole _____

Abandoned _____

Date

M. A. BENEAR

3/24. 192

Scout

Map No. 5444 Sec. 11 Twp. 24 R. 9Well No. 14 Olden
Transcontinental Oil Co. Company

Contractor

SECTION PLAT

Ft. from N. Line

760 Ft. from S. Line1120 Ft. from E. Line

Ft. from W. Line

COMPLETED

Location

Rig up

Drilling and Remarks:

20/30 b/s

RECORD

Cased _____ in., _____ ft.

Sand 2155-2190'

Gas _____

Oil _____

Total Depth 2190'

PRODUCTION

1st 24 hrs. Nat. _____

1st 24 hrs. after shot _____

Gas _____ Cu. Ft.

Dry Hole _____

Abandoned _____

Date

JUN 5 1925

192

CHAS. L. SHERWOOD
Scout