


Section 12 Township 24 Range 9E

Well No. #1 Burk

Company W. McGinnis

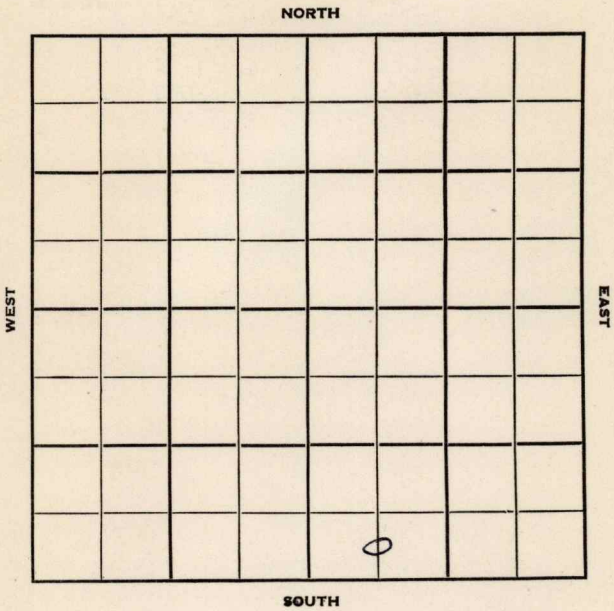

Greenwood

KANSAS

Sec. 12 Twp. 24 R. 9E

Well No. #1 Burk Farm

W. McGinnis Company

Contractor

Wildcat


Ft. from N. Line

330 Ft. from S. Line

Ft. from E. Line

660 Ft. from W. Line

S/2 SW SE

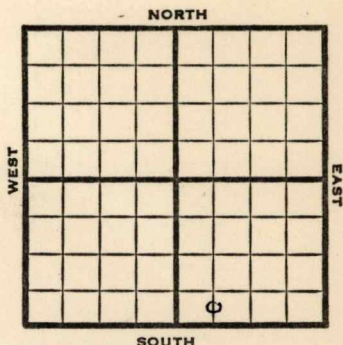

1951

Elev.-

REPORT

10/31

Spud 10-28-51
Drlg. 700'

11/28

Spud 10-28-51
Oil Well TD 2249
Bart. 2205-49
5" @ 2205
TD 2249
Comp. 25 bopd

COMPLETED

Drlg. 700

J. E. TYRA

County **Greenwood** State **Kansas**
 Sec. **12** (Blk. Twp.) **24** (Sur. Rge.) **9E** Map No.
 Operator **W. McGinnis**
 Well No. **1** Farm **Burk**
 Elev. Location **C S L SW SE**



330 Ft. From **S** Line **SE**
660 Ft. From **W** Line **Quarter**
 1st. Report
 Completion **NOV 28 1951**
 Remarks **Wildcat**

Spudding Date **10-28-51**

Drlg. Data **Oil well** **TD 2249**

Bart. 2205-49 5" @ 2205 TD 2249

Comp. 25 bopd

J. E. TYRA