


Woodson Co

Map No. Kansas Sec. 32 Twp. 23 R. 14

Well No. 13 Headley Farm
Pure Oil Co Company

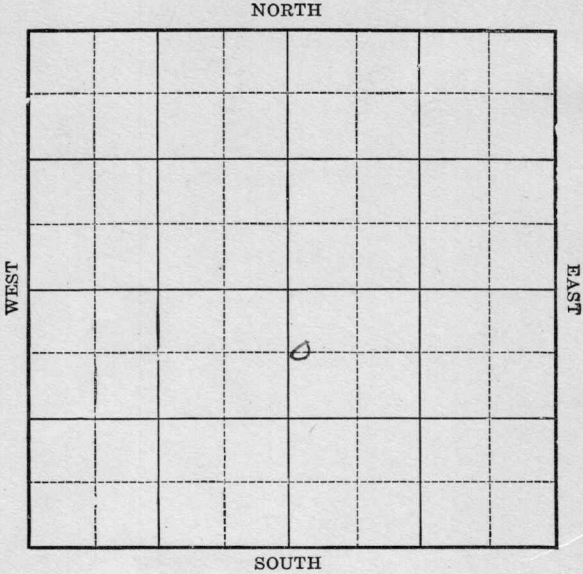

Location _____
Drilling Remarks _____

Rig Up _____
Drilling Remarks _____

RECORD

Cased _____ in. _____ ft.
Sand _____
Gas _____
Oil _____
Total Depth _____

PRODUCTION

1st 24 hrs. Nat. _____
1st. 24 hrs. after shot _____
Gas _____ cu. ft.
Dry Hole _____
Abandoned _____

Woodson Co

Map No. Kansas Sec. 32 Twp. 23 R 14


Well No. 13 Headley Farm
Pure Oil Company

660 Ft. from N. Line

_____ Ft. from S. Line

_____ Ft. from E. Line

700 Ft. from W. Line

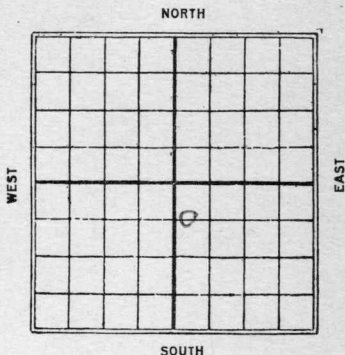

Date 1925

REPORT

8/20 3 1655 slg 1675 in sand

8/26

9/3 7 sand 1655-80
40 gts 30 Bbls

Map No. *KANSAS* Sec. *32* Twp. *23* R. *14*
 Well No. *13* *Headley*
Pulco Oil Co. Company

Contractor

FIRST REPORTS

660 Ft. from N. Line

Ft. from S. Line

Ft. from E. Line

200 Ft. from W. Line

SECTION PLAT

		o	

Location

Rig up

Drilling and Remarks:

*Top Sand 1655**Only 1675' in**Sand.*

RECORD

Cased _____ in., _____ ft.

Sand _____

Gas _____

Oil _____

Total Depth _____

PRODUCTION

1st 24 hrs. Nat. _____

1st 24 hrs. after shot _____

Gas _____ Cu. Ft.

Dry Hole _____

Abandoned _____

Date

AUG 20 1925

CHAS. L. SHERWOOD

192

Scout

Woodson Co

Map No. *No map* **KANSAS** Sec. *32* Twp. *23* R. *14*Well No. *13* *Headley**HW Co*

Company

Contractor

COMPLETED

SECTION PLAT

		o	

660 Ft. from N. Line

Ft. from S. Line

Ft. from E. Line

200 Ft. from W. Line

Location

Rig up

Drilling and Remarks:

RECORD

Cased *1655-80'* in., ft.

Sand

Gas

Oil

Total Depth *1680'*

PRODUCTION

1st 24 hrs. Nat.

1st 24 hrs. after shot

Gas Cu. Ft.

Dry Hole

Abandoned

Date

SEP 3 1925

192

CHAS. L. SHERWOOD

Scout

40/30 bks.