


Section 32 Township 23 Range 14-E
Well No. #19 Headley
Company Pure Oil

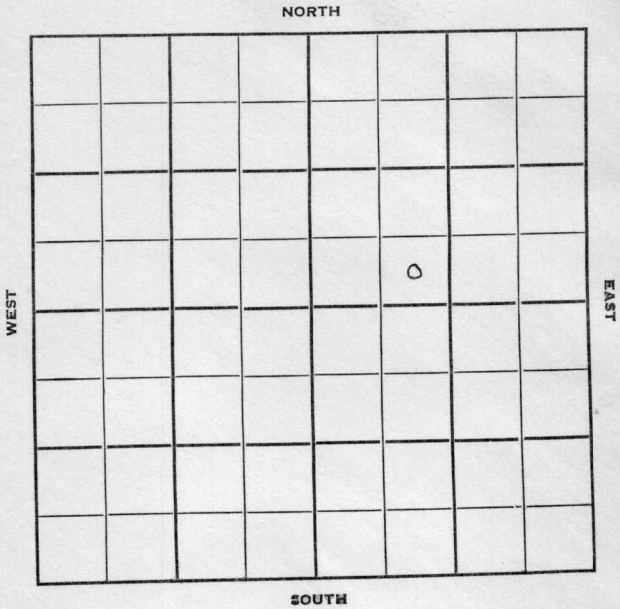

Woodson

KANSAS

Sec. 32 Twp. 23 R. 14E

Well No. #19 Headley Farm

Pure Oil Company

Pure - Contr. Contractor


 Ft. from N. Line

330' Ft. from S. Line


 Ft. from E. Line

990' Ft. from W. Line

SE SW NE

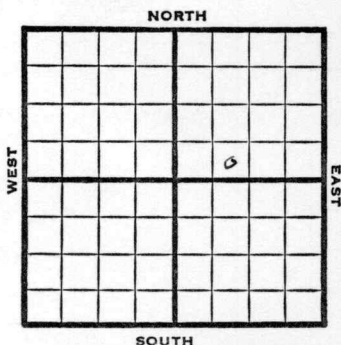

1950	? REPORT
10/25	Spud 10-21-50 8-5/8" @ 66'
11/22	8 5/8" @ 66 Miss 1656-60 5 1/2" @ 1657 TD 1673 10 gopd DD 1692 Comp 20 bopd Completed TD 1692 COMPLETED

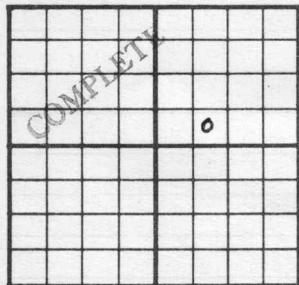County Woodson State KansasSec. 32 (Blk.) 23 (Sur.) 14E Map No.Operator Pure OilWell No. 19 Farm HeadleyElev. Location SE SW NE330 Ft. From S Line NE990 Ft. From W Line Quarter

1st. Report

Completion NOV 22 1950

Remarks

Pure - Contr.Spudding Date 10-21-50Drlg. Data Oil well TD 16928 5/8" @ 66 Miss. 1656-60 5 1/2" @ 1657TD 1673 10 gopd DD 1692Comp. 20 bopd