


Map No. X Sec. 12 Twp. 24 R. 9
 Well No. 3 Canon Farm
Gypsy Company

200 Ft. from N. Line
 _____ Ft. from S. Line
 _____ Ft. from E. Line
200 Ft. from W. Line

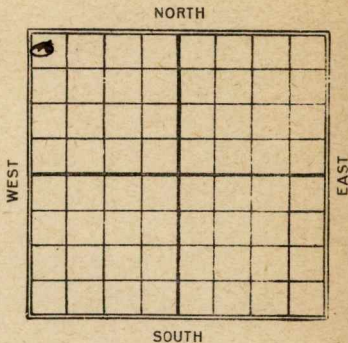

Date

REPORT

1/9/24
4/23 Rig up
4/24 Rig
6/18 2290-2304
 1 w/100 Bbl

Map No. **KANSAS** ¹⁵ Sec. **12** Twp. **34** R. **9**

Well No. **3 Cannon**

Gypsy Company

Contractor

FIRST REPORT

200 Ft. from N. Line

_____ Ft. from S. Line

_____ Ft. from E. Line

200 Ft. from W. Line

SECTION PLAT

0			

Location _____

Rig up **✓✓**

Drilling and Remarks:

RECORD

Cased _____ in., _____ ft.

Sand _____

Gas _____

Oil _____

Total Depth _____

PRODUCTION

1st 24 hrs. Nat. _____

1st 24 hrs. after shot _____

Gas _____ Cu. Ft.

Dry Hole _____

Abandoned _____

Date

APR 23 1924

M. A. BENEAR

192

Scout

15
Map No. **KANSAS** Sec. 12 Twp. 24 R. 9

Well No. 3 Cannon

Gypsy Company

Contractor

COMPLETED

SECTION PLAT

200 Ft. from N. Line

_____ Ft. from S. Line

_____ Ft. from E. Line

200 Ft. from W. Line

0			

Location _____

Rig up _____

Drilling and Remarks:

sand 2290-2300

120/100

RECORD

Cased _____ in., _____ ft.

Sand _____

Gas _____

Oil _____

Total Depth _____

PRODUCTION

1st 24 hrs. Nat. _____

1st 24 hrs. after shot _____

Gas _____ Cu. Ft.

Dry Hole _____

Abandoned _____

Date

JUN 18 1924

M. A. BENEAR

192

Scout