


Woodson

KANSAS

Section 33 Township 23 Range 14-E

Well No. #1 Headley

Company O K O Oil

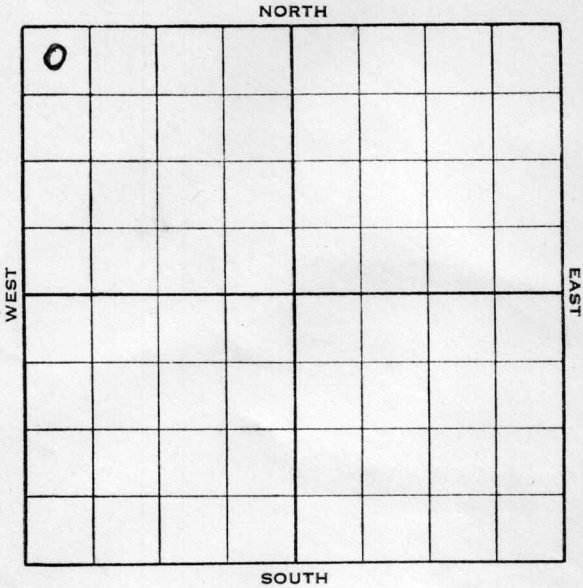


KANSAS

Woodson

Sec. 33 Twp. 23 R. 14-EWell No. #1 Headley FarmOKO Oil Company330 Ft. from N. Line

Ft. from S. Line

Ft. from E. Line

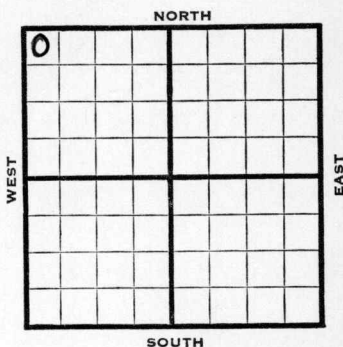330 Ft. from W. Line

1938

REPORT

4/6 8" @ 837'. Miss. 1685'.
 6" @ 1685'. S.O. 1695-1712'.
 Drlg. 1713'.

4/13 6" @ 1685'.
 Miss. 1685'.
 T.D. 1713'.
 500 acid.
 Est. 4 bbls.

COMPLETED

Woodson KANSAS

Map No. 17 Sec. 33 Twp. 23 R. 14EWell No. 1 HeadleyOKO Oil

Company

Contractor

FIRST REPORT

SECTION PLAT

NW/C

330 Ft. from N. Line

Ft. from S. Line

Ft. from E. Line

330 Ft. from W. Line

0			

Location

RECORD

Cased _____ in., _____ ft.

Sand _____

Gas _____

Oil _____

Total Depth _____

PRODUCTION

1st 24 hrs. Nat. _____

1st 24 hrs. after shot _____

Gas _____ Cu. Ft.

Dry Hole _____

Abandoned _____

Rig up

Drilling and Remarks:

8" - 837

Miss 1685

6" - 1685

S.O. 1695-1712

Drlg. 1713

Date

APR 6 - 1938

19

H. D. Hatfield

Scout

Map No. 17 Sec. 33 Twp. 23 R. 14EWell No. 1 HeadleyOKO Oil

Company

Contractor

COMPLETED**SECTION PLAT**

0			

NW/C
330 Ft. from N. Line Ft. from S. Line Ft. from E. Line330 Ft. from W. LineLocation Rig up

Drilling and Remarks:

500 AcidEST 4 bbls**RECORD**Cased 6 in., 1685 ft.Sand MISS 1685Gas Oil Total Depth 1713**PRODUCTION**1st 24 hrs. Nat. 1st 24 hrs. after shot Gas Cu. Ft.Dry Hole Abandoned

Date

APR 13 1938 19H. D. Hatfield Scout