


Section 12 Township 24 S Range 9 E

Well No. #11 Cannon

Company Phillips Petroleum Co.

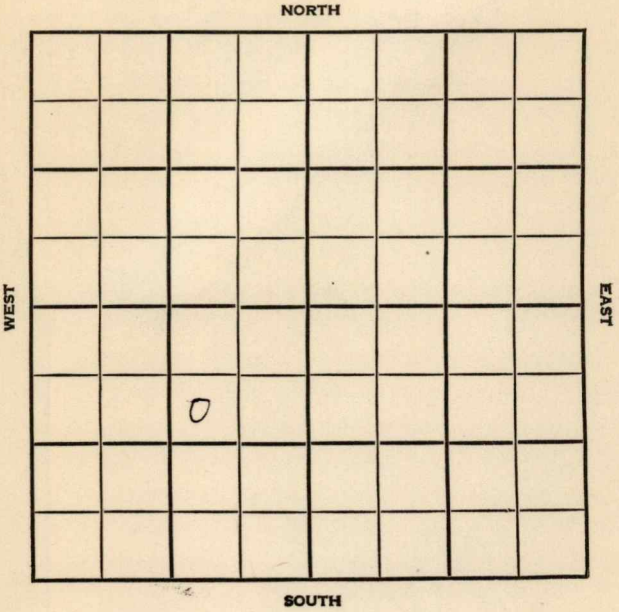

Greenwood

KANSAS

SEC.	TWP.	R.
12	24S	9E

WELL NO.

#11 Cannon

FARM

COMPANY

Phillips Pet Co.

CONTRACTOR

McGinnis

Thzall-Agard


Ft. from N. Line

Ft. from S. Line

Ft. from E. Line

Ft. from W. Line

SW NE SW

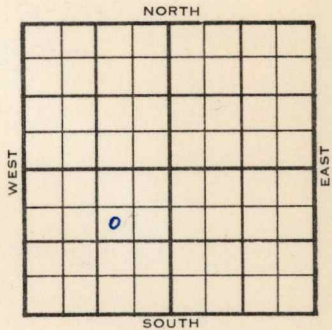

1955

ELEVATION

1208.47 GL

REPORT

9/28

MIRT

10/12

Comm 9-29-55

8 5/8" @ 95/50

KC

1510

BKC

1681

Marm

1794

Ce

1956

Ardmore

2038

Bart

2117

TD 2245

D & A

ABANDONED

County Greenwood Elev. 1208.47 GL
 Sec. 12 Twp. 24S Rge. 9E
 Company Phillips Petroleum Co.
 Farm Name Cannon No. 11

TOPS	DEPTH	LOG	DATUM	Loc. in Sec.
Anh.				SW NE SW
Tr.				
Dg.				
B.L.				
L.				Geol.
K.C.				Contr.
B.K.C.				McGinnis
Ce.				Pool
C.				Thrall-Agard
M.				
M.				
K.				
Mz.				
Ma.				
V.				
S.				
S.				
A				
R.				
Pe.				
G.				
T.D.				

SEP 28 1955

Date Comm.

MIRT

County Greenwood Elev. 1208.47 GL
 Sec. 12 Twp. 21 Rge. 9E
 Company Phillips Pet.
 Farm Name Cannon No. 11

TOPS	DEPTH	LOG	DATUM	Loc. in Sec.
Anh.				SW NE SW
TP.				
H.				
Tr.				
Dg.				
BL.				
L.				Geol.
K.C.		1510	302	
B.K.C.		1681	473	Contr.
Ca. <u>nam</u>		1794	586	McGinnis
G. <u>ce</u>		1956	748	
M. <u>Admow</u>		2038	850	Pool
M. <u>Bart</u>		2117	909	Thrall-Agard
K.				
Mz.				
Mq.				
V.				
S.				
S.				
A.				
R.				
Pe.				
G.				
T.D.	2245			

ABANDONED

Date Comm. 9-29-55 OCT 12 1955

8 5/8" @ 95/50

D & A