


Woodson

KANSAS

Section 33 Township 23 Range 14E

Well No. #25 Ryser

Company Geo. Emery

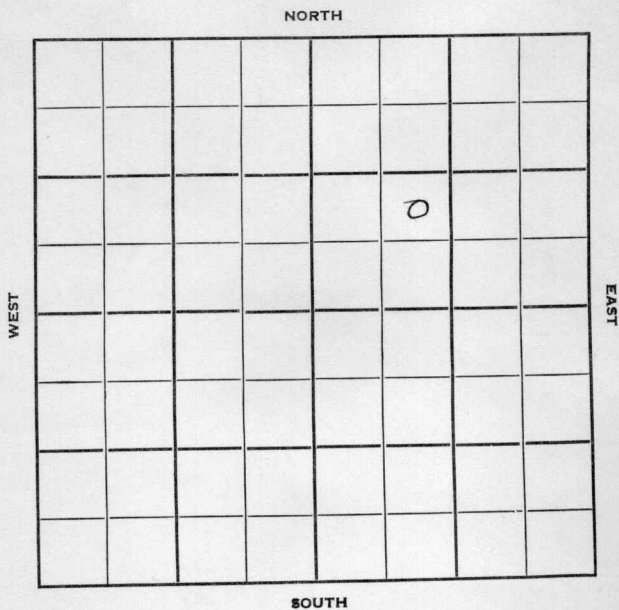

Woodson KANSAS

Sec. 33 Twp. 23 R. 14E

Well No. #25 Ryser Farm

Geo. Emery Company

Contractor

Miscellaneous


Ft. from N. Line

990' Ft. from S. Line

Ft. from E. Line

990' Ft. from W. Line

NE SW NE

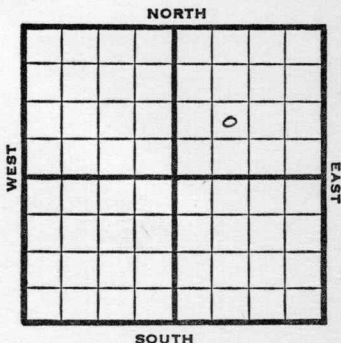

1950

REPORT

4/12 8-5/8" @ 26'
WOC

5/17 TD 1659
8 5/8" @ 26
Miss 1634
4" @ 1634
TD 1659
30 BOPD
Completed

COMPLETED

Kansas

Miscellaneous


Map No. _____ Sec. 33 Twp. 23 R. 14EWell No. 25 Ryser

Geo. Emery _____ Company

Contractor

NE SW NE

SECTION PLAT

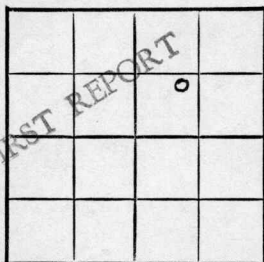

_____ Ft. from N. Line

990 Ft. from S. Line

_____ Ft. from E. Line

990 Ft. from W. Line

Woodson County

Location _____

Rig up _____

Drilling and Remarks:

8 5/8" @ 26

WOC

RECORD

Cased _____ in., _____ ft.

Sand _____

Gas _____

Oil _____

Total Depth _____

PRODUCTION

1st 24 hrs. Nat. _____

1st 24 hrs. after shot _____

Gas _____ Cu. Ft.

Dry Hole _____

Abandoned _____

Date

APR 12 1950

19

J. E. TYRA

Scout

Map No. _____ Sec. 33 Twp. 23 R. 14EWell No. 25 RyserGeo. Emery Company _____

Contractor _____


NE SW NE

SECTION PLAT

_____ Ft. from N. Line

990 Ft. from S. Line

_____ Ft. from E. Line

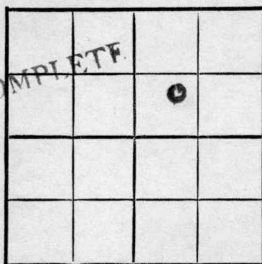990 Ft. from W. LineWoodson

Location _____

Rig up _____

Drilling and Remarks:

8 5/8" @ 26
min 1634
4" @ 1634
T.D. 1659
30 BOPD

RECORD

Cased _____ in., _____ ft.

Sand _____

Gas _____

Oil _____

Total Depth 1659

PRODUCTION

1st 24 hrs. Nat. _____

1st 24 hrs. after shot _____

Gas _____ Cu. Ft.

Dry Hole _____

Abandoned _____

Date

MAY 17 1950
 19

J. E. TYRA
 Scout