


Section 13 Township 24 Range 9E

Well No. #3 Bratten

Company A. R. Jones

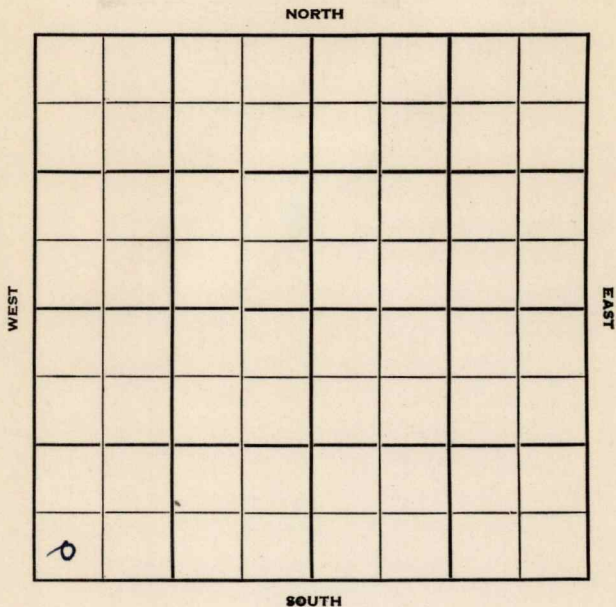

Greenwood

KANSAS

Sec. 13 Twp. 24 R. 9 E ✓

Well No. # 3 Bratten Farm

A. R. Jones Company

Contractor

Ft. from N. Line

330


Ft. from S. Line

Ft. from E. Line

330

Ft. from W. Line

SW SW SW

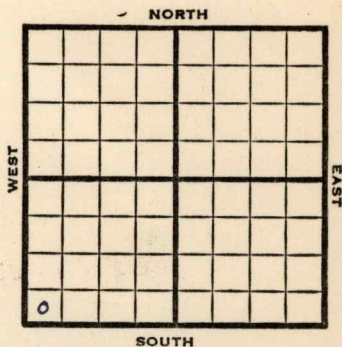

1951

Elev. -

REPORT

10/31

Bart 2248' RTD 2250' 5" @ 2250'
DD to TD 2262'- 30 qts
30 BOPD
Complete

FIRST REPORT

✓
COMPLETED

