FORM 51 10M 7-48 PETROL


KANSAS Woodson

Section 34 Township 23 Range 14E

Well No. 1 Figge

Company Kilby

Misc.

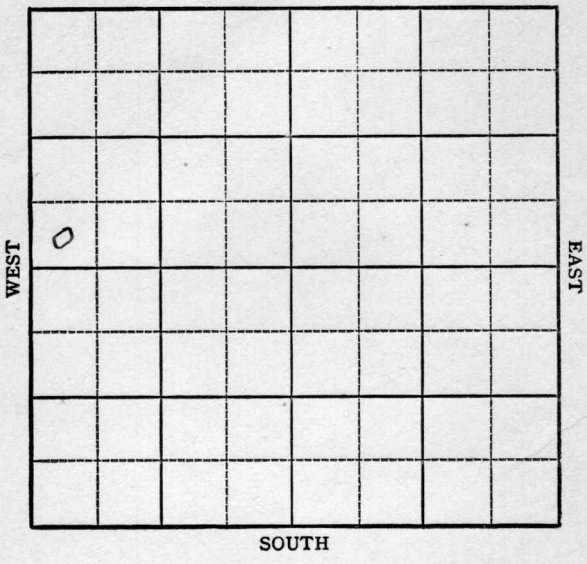

FORM 252-A
5M 10-48 PETROL

KANSAS Woodson ✓

Sec. 34 Twp. 23 R. 14E

Well No. #1 Figge Farm

Kilby Company

Miscellaneous


_____ Ft. from N. Line

330' Ft. from S. Line

_____ Ft. from E. Line

330' Ft. from W. Line

SW NW

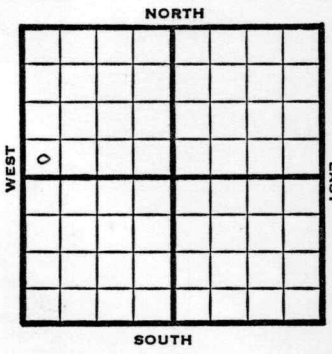

1948	REPORT
10/20	12" @ 34' Drlg. 515'
10/26	Drlg. 950' 8" @ 795'
11/3	Drlg 1400'
11/10	Bart 1475' 5"@ 1551' Drlg 1558'
11/16	"
11/23	TD 1555' Miss 1550' 5" @ 1500' 100 acid Pump 40 Oil Pot 38° Gr. Comp COMPLETED

Form 26 200 Bks. 9-48 Petrol

Kansas

Miscellaneous

Map No. _____ Sec. 34 Twp. 23 R. 14E


Well No. 1 Figge

Kilby Company

FIRST REPORT Contractor

SW NW

SECTION PLAT

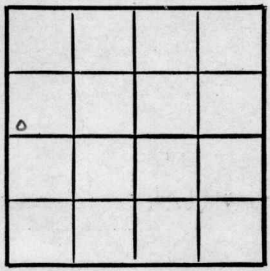

_____ Ft. from N. Line

330 Ft. from S. Line

~~330~~ Ft. from E. Line

330 Ft. from W. Line

Woodson County

Location _____

Rig up _____

Drilling and Remarks:

12" @ 34

drlg. 515

RECORD

Cased _____ in., _____ ft.

Sand _____

Gas _____

Oil _____

Total Depth _____

PRODUCTION

1st 24 hrs. Nat. _____

1st 24 hrs. after shot _____

Gas _____ Cu. Ft.

Dry Hole _____

Abandoned _____

Date

OCT 20 1948 19 S. J. LEWIS Scout

Form 26 200 Bks. 9-48 Petrol

Kansas

Miscellaneous

Map No. 17 Sec. 34 Twp. 23 R. 14E


Well No. 1 Figge

Kilby Company

COMPLETE Contractor

SW NW

SECTION PLAT

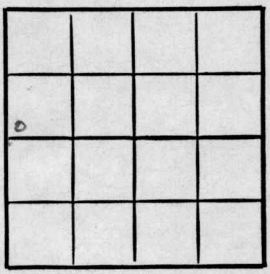

____ Ft. from N. Line

330 Ft. from S. Line

____ Ft. from E. Line

330 Ft. from W. Line

Woodson County

Location

Rig up

Drilling and Remarks:

Miss 1555

5" @ 1500

100 acid

Pmpg 40 oil BO

35° Gr

RECORD

Cased ____ in., ____ ft.

Sand

Gas

Oil

Total Depth 1555

PRODUCTION

1st 24 hrs. Nat.

1st 24 hrs. after shot

Gas ____ Cu. Ft.

Dry Hole

Abandoned

Date

NOV 23 1948 19

S. J. LEWIS Scout