


Section 34 Township 23 Range 14E

Well No. #6 Figge

Company E. E. Kilbe

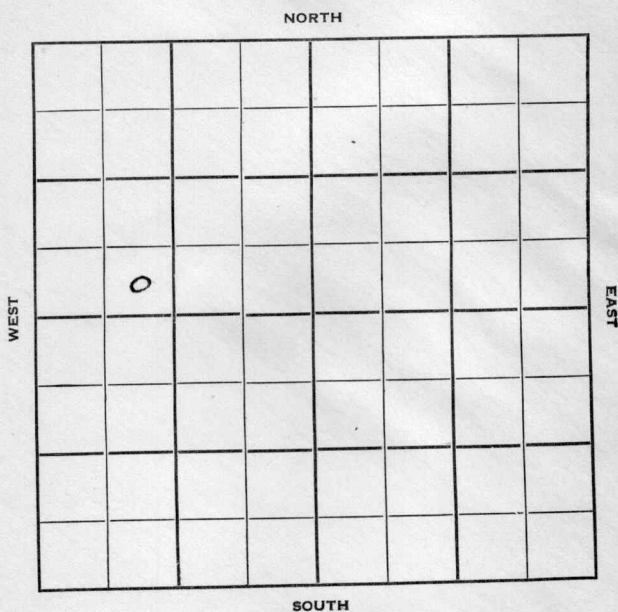

Woodson

KANSAS

Sec. 34 Twp. 23 R. 14E

Well No. #6 Figge Farm

E. E. Kilbe Company

Miscellaneous Contractor

 Ft. from N. Line

330'


 Ft. from S. Line

 Ft. from E. Line

990'

 Ft. from W. Line

SE SW NW

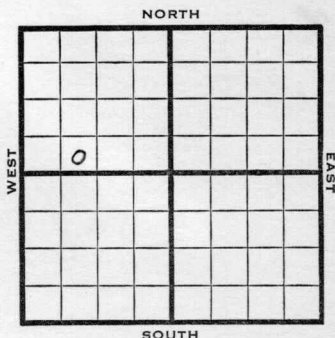

1950	Elev.	REPORT
2/8	Spud 1-27-50 10" @ 816' 8" @ 1225' Drlg. 1450'	
3/1	10" @ 816' 6-5/8" @ 1653' Show oil @ 1655-59 50 BOPD TD 1672' COMPLETED	

Map No. _____ Sec. 34 Twp. 23 R. 14EWell No. 6 FiggeE. E. Kilbe Company

Contractor

SE SW NW

SECTION PLAT

_____ Ft. from N. Line

330 Ft. from S. Line

_____ Ft. from E. Line

990 Ft. from W. Line

Woodson County

Location _____

Rig up _____

Drilling and Remarks:

Spud 1-27-50

10" @ 816

8" @ 1225

drlg. 1450

RECORD

Cased _____ in., _____ ft.

Sand _____

Gas _____

Oil _____

Total Depth _____

PRODUCTION

1st 24 hrs. Nat. _____

1st 24 hrs. after shot _____

Gas _____ Cu. Ft.

Dry Hole _____

Abandoned _____

Date

FEB 8 1950 19

J. E. TYRA

Scout

Kansas

Miscellaneous

Map No. _____ Sec. 34 Twp. 23 R. 14EWell No. 6 FiggeE. E. Kilbe Company

Contractor

SE SW NW

SECTION PLAT

	o	COMPLETE	

_____ Ft. from N. Line

330 Ft. from S. Line

_____ Ft. from E. Line

990 Ft. from W. Line

Woodson County

Location _____

Rig up _____

Drilling and Remarks:

10" @ 8166 5/8" @ 1653Show oil @ 1655-5950 BOPD

RECORD

Cased _____ in., _____ ft.

Sand _____

Gas _____

Oil _____

Total Depth 1672

PRODUCTION

1st 24 hrs. Nat. _____

1st 24 hrs. after shot _____

Gas _____ Cu. Ft.

Dry Hole _____

Abandoned _____

Date

MAR 1 1950J. E. TYRA

Scout