


Section 34 Township 23 Range 14E
 Well No. #8 Figgie (*Figge*)
 Company E. E. Kilby

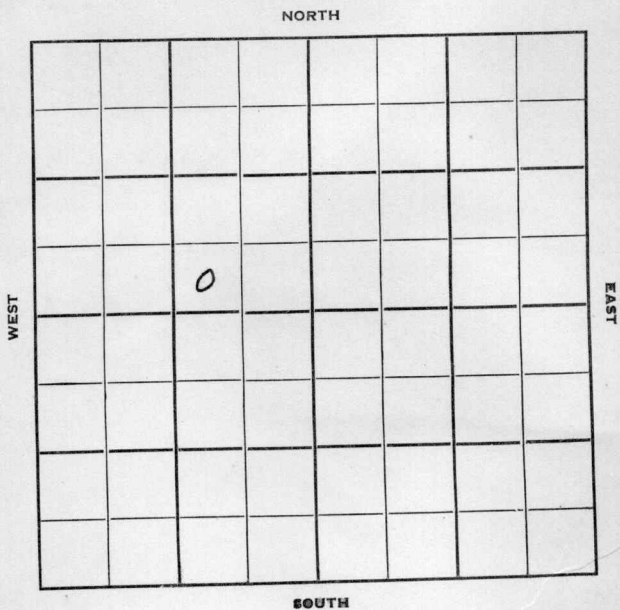

Woodson

KANSAS

Sec. 34 Twp. 23 R. 14E

Well No. #8 Figgie Farm

E. E. Kilby Company

Kilby - Contr. Contractor


 Ft. from N. Line

330' Ft. from S. Line

990' Ft. from E. Line

 Ft. from W. Line

SW SE NW

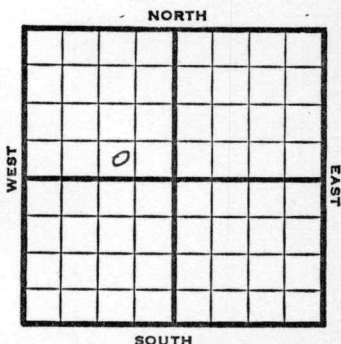

1951	Elev. - REPORT
10/24	Spud 10-15-51 8" @ 835' Drlg. 1000'
11/28	Spud 10-15-51 Oil Well TD 1719 8" @ 835 Miss 1665 5" @ 1668 TD 1719 1000 A Comp. 25 bopd COMPLETED

County Woodson State Kansas
 Sec. 34 (Blk. 23) (Sur. 14E) Map No. _____
 (Twp.)
 Operator E. E. Kilby
 Well No. 8 Farm Figgie
 Elev. _____ Location SW SE NW

0

FIRST REPORT

330 Ft. From S Line NW
990 Ft. From E Line Quarter
 1st. Report OCT 24 1951
 Completion _____
 Remarks Kilby - Contr.
 Spudding Date 10-15-51

Drlg. Data

8" @ 835 drlg. 1000

J. E. TYRA

County Woodson State KansasSec. 34 (^{Blk.}_{Twp.}) 23 (^{Sur.}_{Rge.}) 14E Map No.Operator E. E. KilbyWell No. 8 Farm FiggieElev. Location SW SE NW

0

COMPLETE

330 Ft. From S Line NW

990 Ft. From E Line Quarter

1st. Report

Completion NOV 28 1951

Remarks

Kilby - Contr.

Spudding Date 10-15-51

Drlg. Data Oil well TD 1719

8" @ 835 Miss. 1665 5" @ 1668

TD 1719 1000 A Comp. 25 bopd

J. E. TYRA