

Butler Co

Map No. *Kans.* Sec. *29* Twp. *25* R. *5*


Well No. *31- Finney* Farm

Empire G.-F. Company

NORTH

WEST

EAST

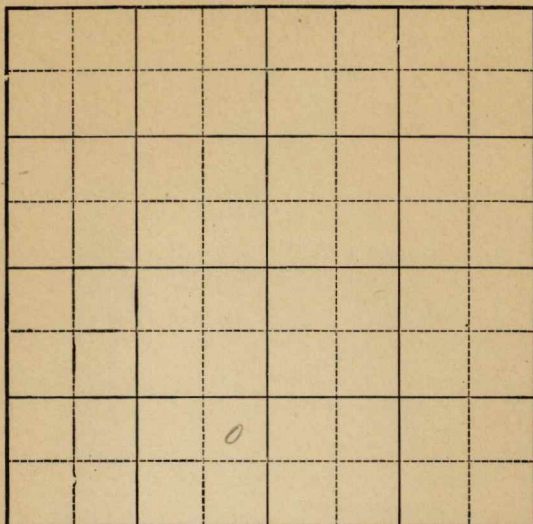

SOUTH

Location _____

Drilling Remarks

Rig Up _____

Drilling Remarks

RECORD

Cased _____ in. _____ ft.

Sand _____

Gas _____

Oil _____

Total Depth _____

PRODUCTION

1st 24 hrs. Nat. _____

1st 24 hrs. after shot _____

Gas _____ cu. ft.

Dry Hole _____

Abandoned _____


Butler

Map No. Kansas Sec. 29 Twp. 25 R. 5Well No. 31 Finney FarmEmpire H. & F Company

Ft. from N. Line

792 Ft. from S. Line793 Ft. from E. Line

Ft. from W. Line

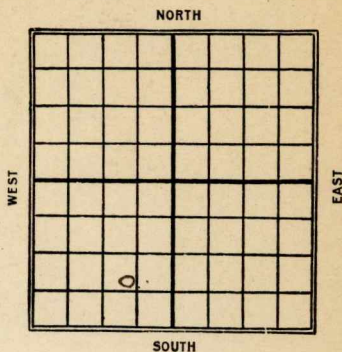

Date

REPORT

7/264/21Location4/30SL 245.5/5Sd. 665-683 J.D. 693.15/15.

1214 KANSAS Sec. 29 Twp. 25 R. 5
 Map No. 31 Finney
 Well No. Empire Oil & Gas Co.
 Company

Contractor

FIRST REPORTS

SECTION PLAT

Ft. from N. Line

792 Ft. from S. Line

792 Ft. from E. Line

Ft. from W. Line

Location ✓

Rig up

Drilling and Remarks:

RECORD

Cased _____ in., _____ ft.

Sand _____

Gas _____

Oil _____

Total Depth _____

PRODUCTION

1st 24 hrs. Nat. _____

1st 24 hrs. after shot _____

Gas _____ Cu. Ft.

Dry Hole _____

Abandoned _____

Date

APR 21 1926

192

CHAS. L. SHERWOOD
Scout

K14 **KANSAS** Sec. 29 Twp. 25 R. 5
 Map No. 31 Finney
 Well No. Combie 302 Co.
 Company _____
 Contractor _____

COMPLETED**SECTION PLAT**

_____ Ft. from N. Line

792 _____ Ft. from S. Line

792 _____ Ft. from E. Line

_____ Ft. from W. Line

Location _____

Rig up _____

Drilling and Remarks:

15/15 BS.
RECORDCased 665-693 in. _____ ft.

Sand _____

Gas _____

Oil _____

Total Depth 693**PRODUCTION**

1st 24 hrs. Nat. _____

1st 24 hrs. after shot _____

Gas _____ Cu. Ft.

Dry Hole _____

Abandoned _____

Date

CHAS. L. SHERWOOD**MAY 5 1926**192

Scout