


Section 7 Township 24 S Range 5 E

Well No. #2 Shephard

Company Rex & Morris

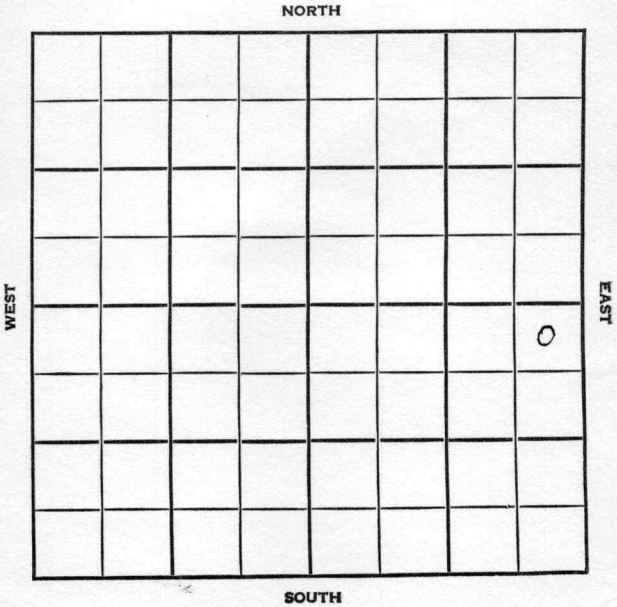

Butler		KANSAS
SEC.	TWP.	R.
7	24S	5E

WELL NO. #2 Shephard FARM

COMPANY Rex & Morris


CONTRACTOR Co. Tools Wildcat

_____ Ft. from N. Line

_____ Ft. from S. Line

_____ Ft. from E. Line

_____ Ft. from W. Line

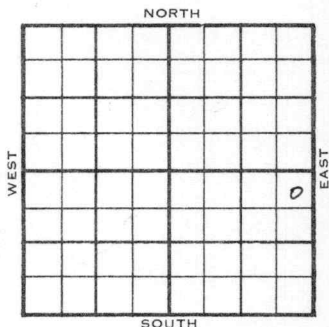

N^E NE SE

	ELEVATION	REPORT
1955		
9/28	MIRT	
10/5	Comm 9-27-55 8 5/8" @ 116/30 KC 2092 BKC 2252 Ch 2457 Lm 2513 D & A	ABANDONED

TOPS	DEPTH	LOG	DATUM	Loc. in Sec. _____
Anh.				NE NE SE
TP.				
H.				
Tr.				
Dg.				
BL.				
L.				Geol. _____
K.C.				Contr. _____
B.K.C.				
Ce.				Co tools
C.				
M.				
M.				Pool _____
K.				Wildcat
Mz.				
Mq.				9
V.				
S.				
S.				
A				
R.				
PE.				
G.				
T.D.				

[illegible]

County Butler Elev. _____
 Sec. 7 Twp. 24 Rgs. 5E
 Company Rex & Morris
 Farm Name Shephard No. 2

TOPS	DEPTH	LOG	DATUM
Anh.			
Tr.			
H.			
Tr.			
Dg.			
BL.			
L.			
K.C.	2092		
B.K.C.	2252		
Ce.			
C.			
M. <i>ch.</i>	2457		
M. <i>cm</i>	2513		
K.			
Mz.			
Me.			
V.			
S.			
S.			
A.			
R.			
P.C.			
G.			
T.D.	2514		

Loc. in Sec. _____

NE NE SE

Geol. _____

Contr. _____

Co. tools _____

Pool _____

Wildcat



Date Comm. 9-27-55 OCT 5 1955

8 5/8" @ 116/30

D & A