


Map No. Kansas Sec. 29 Twp. 25 R. 5
Well No. 28 Fenny Farm
Empire L. & F. Company

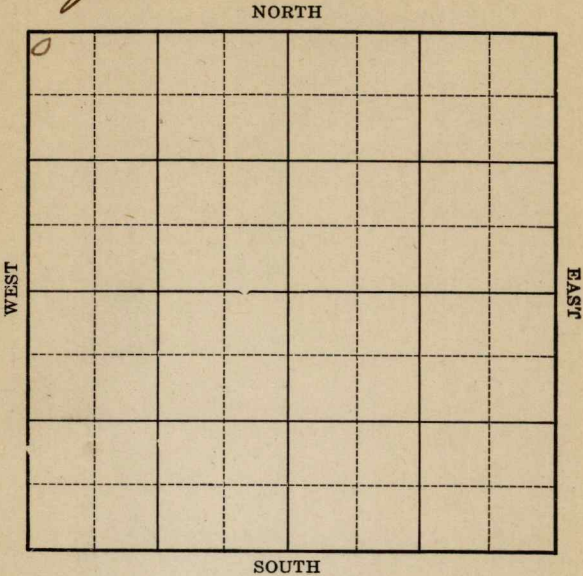

Location _____
Drilling Remarks _____

Rig Up _____
Drilling Remarks _____

RECORD

Cased _____ in. _____ ft.
Sand _____
Gas _____
Oil _____
Total Depth _____

PRODUCTION

1st 24 hrs. Nat. _____
1st 24 hrs. after shot _____
Gas _____ cu. ft.
Dry Hole _____
Abandoned _____

Butler Co

Map No. Kansas Sec. 29 Twp. 25 R 5

Well No. 28 Frenney Farm
Empire G. & F Company

NORTH

WEST

EAST

SOUTH

250 Ft. from N. Line

_____ Ft. from S. Line

_____ Ft. from E. Line

250 Ft. from W. Line

REPORT

Date 1925

8/19 Dlg 1570'

9/24 8 1/4 2150'

10/1 Top Sand 2454-2468-2000' oil in hole

10/8 Sand 2454-2468

50 Bbl natural

14 **KANSAS** Sec. 29 Twp. 25 R. 5

Well No. 28 *Finney*
Compio *Blitz Co* Company

Contractor

FIRST REPORTS

SECTION PLAT

250 Ft. from N. Line

Ft. from S. Line

Ft. from E. Line

250 Ft. from W. Line

0			

Location

Rig up

Drilling and Remarks:

Only 1570'

RECORD

Cased _____ in., _____ ft.

Sand _____

Gas _____

Oil _____

Total Depth _____

PRODUCTION

1st 24 hrs. Nat. _____

1st 24 hrs. after shot _____

Gas _____ Cu. Ft.

Dry Hole _____

Abandoned _____

Date

SEP 19 1925

CHAS. L. SHERWOOD

192

Scout

Butler Co

K 14 Map No. **KANSAS** Sec. **29** Twp. **25** R. **5**Well No. **28** **Finney**
Empire Oil Co Company

Contractor

COMPLETED

SECTION PLAT

250

Ft. from N. Line

Ft. from S. Line

Ft. from E. Line

250

Ft. from W. Line

0			

Location

Rig up

Drilling and Remarks:

50 bbls natural

RECORD

Cased in, ft.

Sand 2454-2468

Gas

Oil

Total Depth 2468

PRODUCTION

1st 24 hrs. Nat.

1st 24 hrs. after shot

Gas Cu. Ft.

Dry Hole

Abandoned

Date

OCT 8 1925

192

CHAS. L. SHERWOOD

Scout