

3-49 PEI
Butler

Section 29 Township 25 Range 5E

Well No. #56 Finney

Company Cities Service Oil Company

NORTH

WEST

EAST

0


SOUTH

Butler

KANSAS

Sec. 29 Twp. 25 R. 5EWell No. #56 Finney FarmCities Service Oil Company CompanyTrans -Era - Contr. Contractor Ft. from N. Line330 Ft. from S. Line330 Ft. from E. Line Ft. from W. Line

SE SE SW

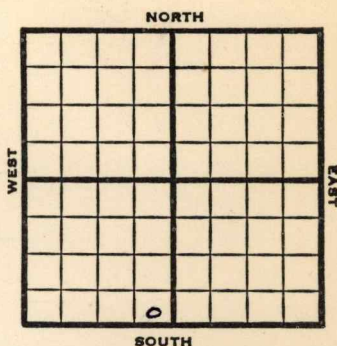

1953

Elev. 1393'

REPORT

3/18

Spudded 3/14/53

8" @ 80

Drlg. 1730

4/29

Spud 3-14-53 Oil well TD 2584
8" @ 80 Br. lime 1630' Lans 1721'

KC 2005 B KC 2144 Viola 2466

Simp 2483 TD 2553 5" @ 2553

DD 2584 4 BWPH PB 2545

39/2535-43 24/2488-93 FU 1600'

wtr. 2 hr. PB 2475 68/2465-73

500 A 8 BO 156 BW 21 hrs.

20/2480-82 3 BWPH CO to 2470

32/2465-70 500 A CO to 2478

65/2466-77 2000 A PB 2247

48/2015-28 72/2037-56 2000 A

Comp. 10 BOPD 80 BW

COMPLETED

COMPLETE

Spudding Date 3-14-53

Comp. 10 bopd 80 bw

J. G. McGEHEE