


Section 29 Township 25 Range 5E

Well No. #55 Finney

Company Cities Service

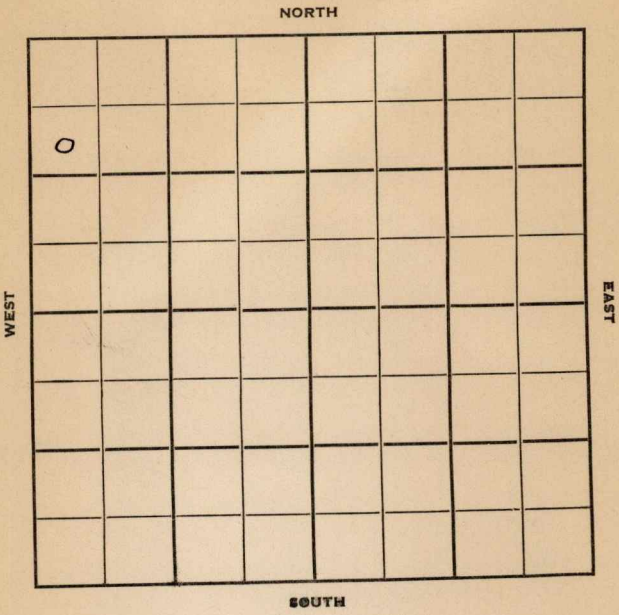

Butler **KANSAS**

Sec. 29 Twp. 25 R. 5E ✓

Well No. #55 Finney Farm

Cities Service Company

B & R Drlg. - Contr. Contractor


990' Ft. from N. Line

 Ft. from S. Line

 Ft. from E. Line

330' Ft. from W. Line

SW NW NW

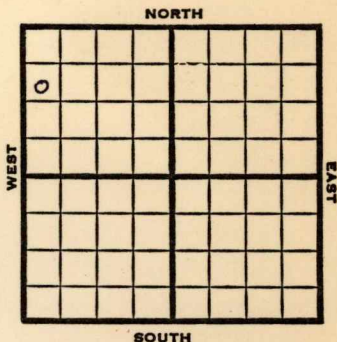

1951 **Elev. 1399'** REPORT

8/8 8" @ 81
Drlg. 320'

8/15 D&A TD 2580
8" @ 81
Doug 1530 Lans. 1751
KC 2042 Viola 2560
TD 2580
D&A
ABANDONED

