


Section 6 Township 24 Range 5E

Well No. #5 Arthur

Company Rex & Morris

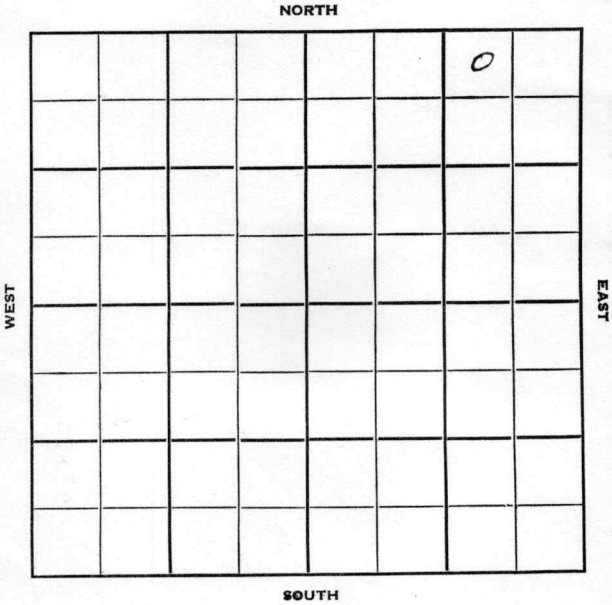

Butler

Sec. 6 Twp. 24 R. 5E ✓

Well No. #5 Arthur Farm

Rex & Morris Company

Contractor


330' Ft. from N. Line

_____ Ft. from S. Line

990' Ft. from E. Line

_____ Ft. from W. Line

NW NE NE

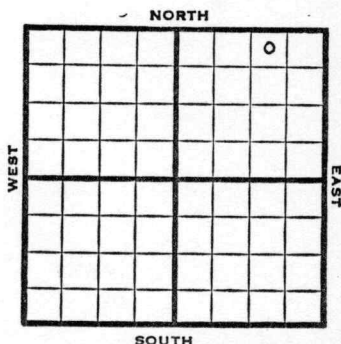

1951

Elev. 1486' REPORT

11/14

Set surf.

1952

1/2

D & A TD 2518' 10" @ 105'

Cong. 2458' Miss 2415' 5" @ 2479'

TD 2518' D & A

ABANDONED

County

Butler

State

Kansas

Sec.

6

(Blk.)
(Twp.)

24

(Sur.)
(Rge.)

5E

Map No.

Operator

Rex & Morris

Well No.

5

Farm

Arthur

Elev.

Location

NW NE NE

0

FIRST REPORT

330 Ft. From

Line

1

Line

THE

990 Et From

Line

3

Line

Quarter

1st. Report

NOV 14 1951

149V

14

1951

51

100

Completion

Remarks

Spudding Date

Drlg. Data

Set Surf.

J. E. TYRA

County Butler State Kansas
 Sec. 6 (Blk.) 2 4 (Sur.) 5E Map No.

Operator Rex & Morris

Well No. 5 Farm Arthur

Elev. 1486 Location NW NE NE

330 Ft. From N Line NE

990 Ft. From E Line Quarter

1st. Report

Completion JAN 2 1952

Remarks

Spudding Date

Drig. Data D & A TD 2518

10" @ 105 Cong. 2458 Miss. 2415

5" @ 2479 TD 2518

D & A

J. E. TYRA