


Section 4 Township 24 Range 5 E

Well No. #1 Frerking

Company Rex & Morris

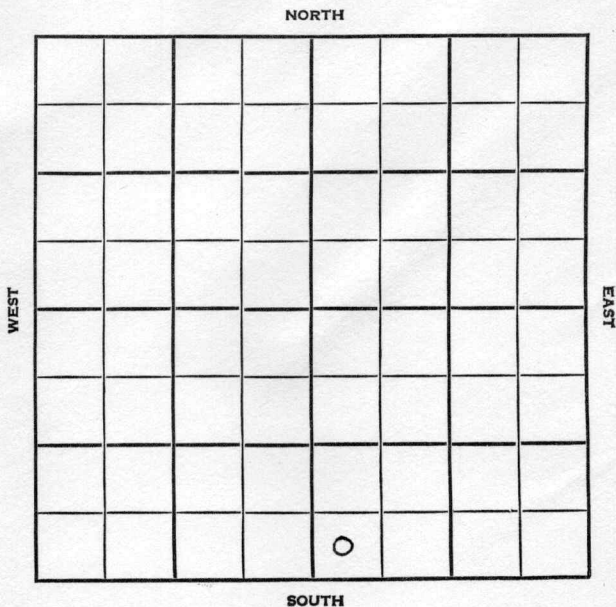

Butler

KANSAS

SEC.

4

TWP.

24

R.

5E

WELL NO.

#4 Frerking

FARM

COMPANY

Rex & Morris

CONTRACTOR

Co Tools

Wildcat


Ft. from N. Line

Ft. from S. Line

Ft. from E. Line

Ft. from W. Line

SW SW SE

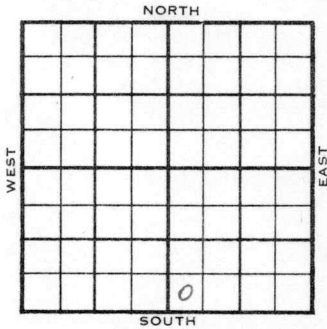

1955

ELEVATION

11432

REPORT

10/5

Comm 10-2-55

8" @ 123/110

WOC

10/12

Comm 10-2-55

8" @ 123/110

D & A

KC

1790

C

2487

M

2515

ABANDONED

County

Butler

Elev.

Sec.

4

Twp.

24

Rge.

5E

Company

Rex & Morris

Farm Name

Frerking

No.

4

TOPS

DEPTH

LOG

DATUM

Loc. in Sec.

Anh.

T.p.

H.

Tr.

Dg.

B.L.

L.

K.C.

B.K.C.

Ce.

C.

M.

M.

K.

Mz.

Mq.

V.

S.

S.

A.

R.

P.E.

G.

T.D.

SW SE

Geol.

Contr.

Co. tools

Pool

Wildcat

FIRST REPORT
OCT 5 '55

Date Comm. 10-2-55

8" @ 123/110 WOC

Co.

Lse.

No.

Sec.

T.

R.

County Butler Elev. 1432
 Sec. 14 Twp. 24 Rge. 5E
 Company Rex & Morris
 Farm Name Frerking No. 4

TOPS	DEPTH	LOG	DATUM	Loc. in Sec.
Anh.				SW SW SE
Tp.				
H.				
Tr.				
Dg.				
Bl.				
L.				Geol.
K.C.	1790		358	Contr.
B.K.C.				Co. tools
Ce.				Pool
C.	2487		1055	Wildcat
M.	2515		1083	
M.				ABANDONED
K.				
Mz.				
Mo.				
V.				
S.				
S.				
A.				
R.				
Pe.				
G.				
T.D.	2550			

Date Comm. 10-2-55 OCT 12 1955
 8" @ 123/110

D & A