

Empire L & F Company

WEST

EAST

COMPLETED

SOUTH

Rig Up -----

Drilling Remarks:

PRODUCTION

1st 24 hrs. Nat.-----


1st 24 hrs. after shot-----

Gas _____ cu. ft.

Dry Hole -----

Abandoned -----

1003 *R14*
Map No. *31* Sec. *25* Twp. *5* R. *5*
Well No. *46 Adams*
Empire Company
Contractor

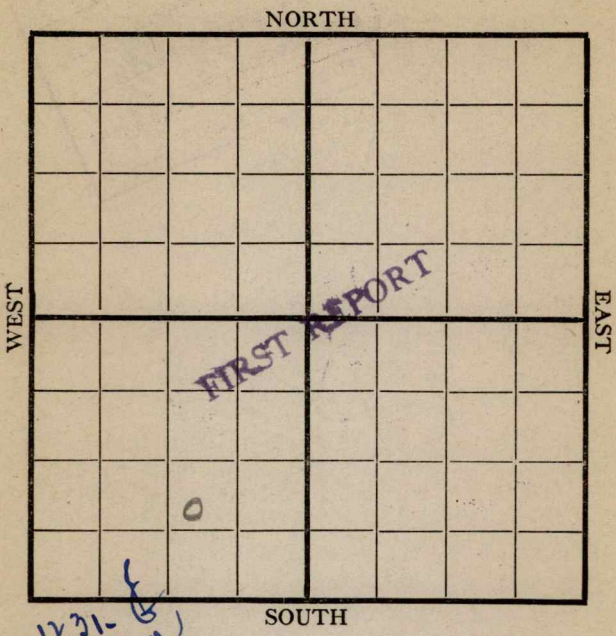

Location *1231-6*
798-N
1409
130
89
Rig up
Drilling and Remarks:
798' N
1409' E

RECORD

Cased _____ in., _____ ft.
Sand _____
Gas _____
Oil _____
Total Depth _____

PRODUCTION

1st 24 hrs. Nat. _____
1st 24 hrs. after shot _____
Gas _____ Cu. Ft.
Dry Hole _____
Abandoned _____

Date *7/24* *8* 191 *C. yls* Scout


Map No. _____ Sec. 31 Twp. 25 R. 5Well No. 46 Adams
Empire _____ Company

Contractor

NORTH

WEST

EAST

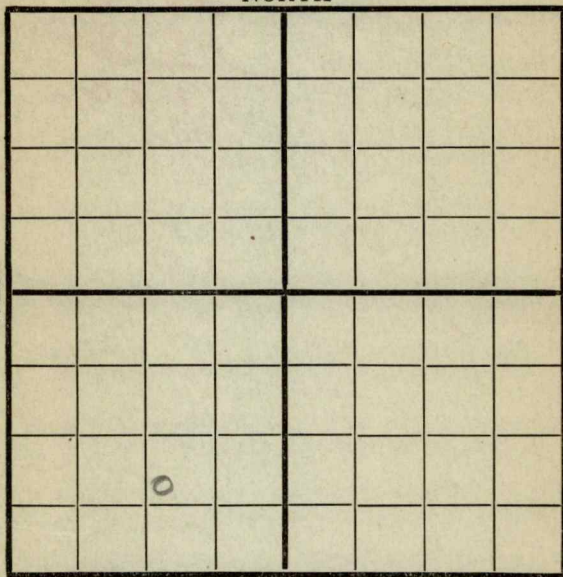

SOUTH

Location ✓

Rig up _____

Drilling and Remarks:

798' D
1231 E

RECORD

Cased _____ in., _____ ft.

Sand _____

Gas _____

Oil _____

Total Depth _____

PRODUCTION

1st 24 hrs. Nat. _____

1st 24 hrs. after shot _____

Gas _____ Cu. Ft.

Dry Hole _____

Abandoned _____

Date

7/31 1918 Oy u Scout

Map No. _____ Sec. 31 Twp. 25 R. 5
 Well No. 46 Adams
Empire Company
 Contractor _____

NORTH								
WEST								EAST
SOUTH								

798 ✓ 1231 8
 Location _____

Rig up _____

Drilling and Remarks:

RECORD

Cased _____ in., _____ ft.

Sand _____

Gas _____

Oil _____

Total Depth _____

PRODUCTION

1st 24 hrs. Nat. _____

1st 24 hrs. after shot _____

Gas _____ Cu. Ft.

Dry Hole _____

Abandoned _____

Date

7 8 191 8 Pyle Scout

Map No. _____ Sec. 31 Twp. 25 R. 5

Well No. 46 Adams
Empire Company
Contractor

NORTH

WEST

EAST

SOUTH

RECORD

Location 15217

Rig up Sand

Drilling and Remarks: _____ Gas -----

Oil _____

Total Depth.....

PRODUCTION

1st 24 hrs. Nat. -----

1st 24 hrs. after shot-----

Gas.....Cu. Ft.

Dry Hole

Abandoned.....

Date _____

8/13 1918 Cyl Scout


Map No. K14 Sec. 31 Twp. 25 R. 5EWell No. 46 AdamsEmpire Company

Contractor

NORTH

WEST

EAST

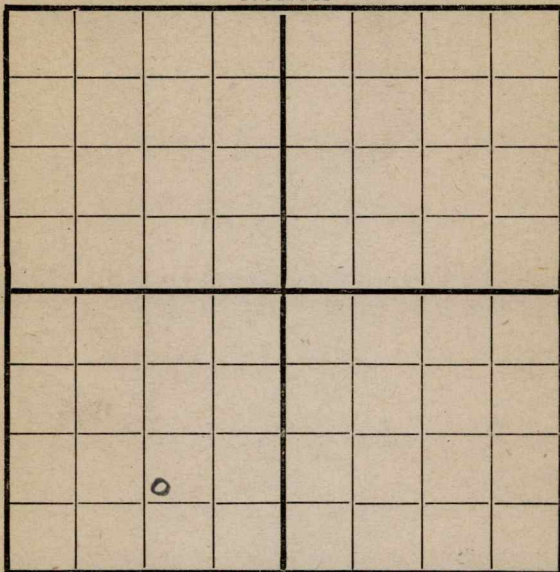

SOUTH

Location

798 N1409 E 1231 ERig up ☒

Drilling and Remarks:

RECORD

Cased _____ in., _____ ft.

Sand _____

Gas _____

Oil _____

Total Depth _____

PRODUCTION

1st 24 hrs. Nat. _____

1st 24 hrs. after shot _____

Gas _____ Cu. Ft.

Dry Hole _____

Abandoned _____

Date

8
28

191

8

Pyle

Scout

Map No. _____ Sec. 31 Twp. 25 R. 5Well No. 46 Adams


Company _____

Contractor _____

NORTH

WEST

EAST

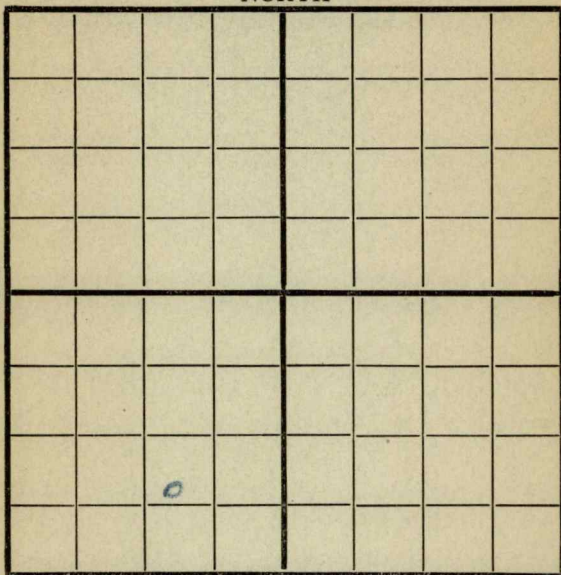

SOUTH

798'D-1231'2

Location _____

Rig up ☒

Drilling and Remarks:

RECORD

Cased _____ in., _____ ft.

Sand _____

Gas _____

Oil _____

Total Depth _____

PRODUCTION

1st 24 hrs. Nat. _____

1st 24 hrs. after shot _____

Gas _____ Cu. Ft.

Dry Hole _____

Abandoned _____

Date

8/21

191

Pyle

Scout


Map No. K14 Sec. 31 Twp. 25^S R. 5^EWell No. 46 AdamsEmpire Company

Contractor

NORTH

WEST

EAST

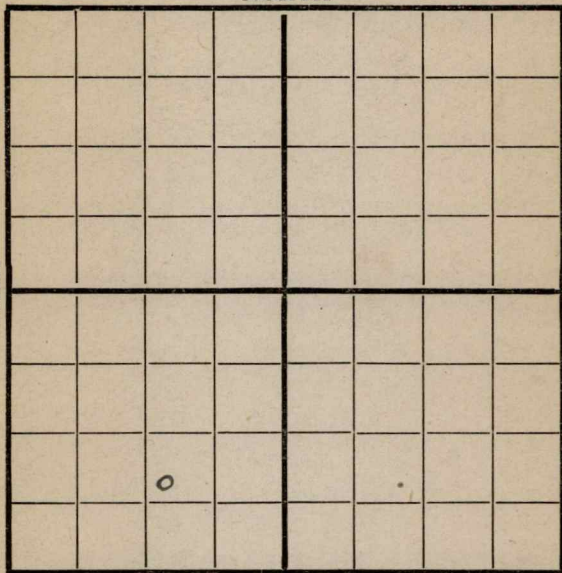

SOUTH

Location ✓

Rig up

Drilling and Remarks:

798 from S.
1409 " 26

RECORD

Cased _____ in., _____ ft.

Sand _____

Gas _____

Oil _____

Total Depth _____

PRODUCTION

1st 24 hrs. Nat. _____

1st 24 hrs. after shot _____

Gas _____ Cu. Ft.

Dry Hole _____

Abandoned _____

Date

9/5 1918

Pyle

Scout


Map No. K14 Sec. 31 Twp. 25 R. 5 ^S ^EWell No. 46 AdamsEmpire Company

Contractor

NORTH

WEST

EAST

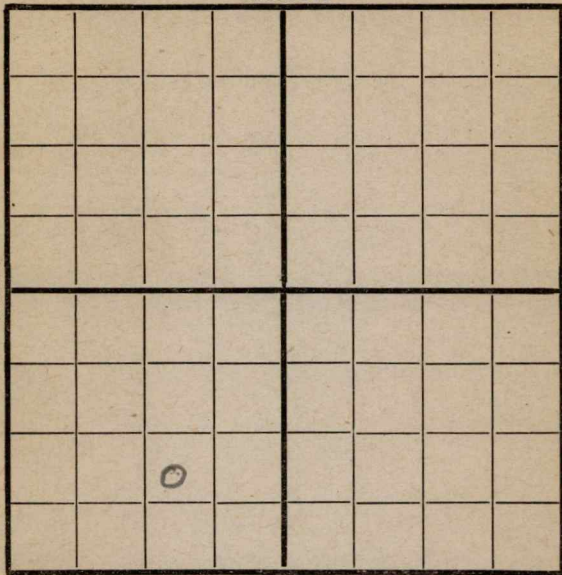

SOUTH

Location 798 A
1231 E

Rig up

Drilling and Remarks:

RECORD

Cased _____ in., _____ ft.

Sand _____

Gas _____

Oil _____

Total Depth _____

PRODUCTION

1st 24 hrs. Nat. _____

1st 24 hrs. after shot _____

Gas _____ Cu. Ft.

Dry Hole _____

Abandoned _____

Date

9/11

1918

Pyle

Scout


Map No. K 14 Sec. 31 Twp. 25^S R. 5^EWell No. 46 AdamsEmpire Company

Contractor

NORTH

WEST

EAST

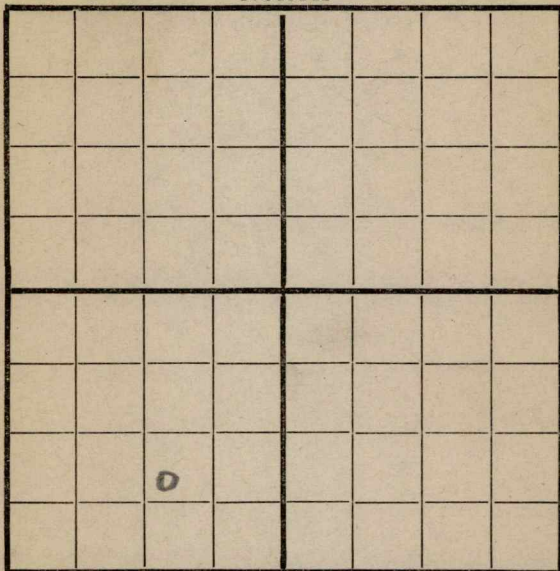

SOUTH

✓ Location 798-SRig up 1409-E

Drilling and Remarks:

RECORD

Cased _____ in., _____ ft.

Sand _____

Gas _____

Oil _____

Total Depth _____

PRODUCTION

1st 24 hrs. Nat. _____

1st 24 hrs. after shot _____

Gas _____ Cu. Ft.


Dry Hole _____

Abandoned _____

Date

9/18 1918 Ryle Scout

Map No. K 14 Sec. 31 Twp. 25 R. 5
Well No. H 6 Adams
Empire Company
Contractor

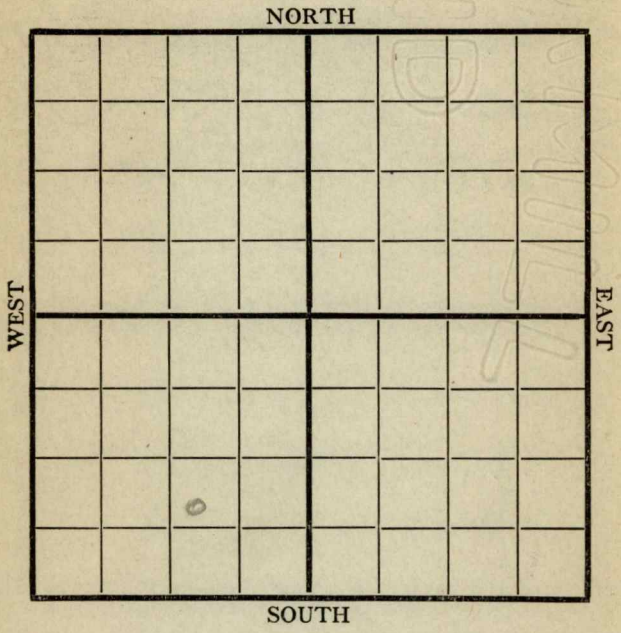

✓ Location 798 S
1231 S
Rig up 1231 S
Drilling and Remarks:

RECORD

Cased _____ in., _____ ft.
Sand _____
Gas _____
Oil _____
Total Depth _____

PRODUCTION

1st 24 hrs. Nat. _____
1st 24 hrs. after shot _____
Gas _____ Cu. Ft.
Dry Hole _____
Abandoned _____

Date 9/26 1918 **Pyle** Scout


Map No. 114 Sec. 31 Twp. 25 R. 5Well No. 46 AdamsCompany Empire

Contractor _____


NORTH

WEST

EAST

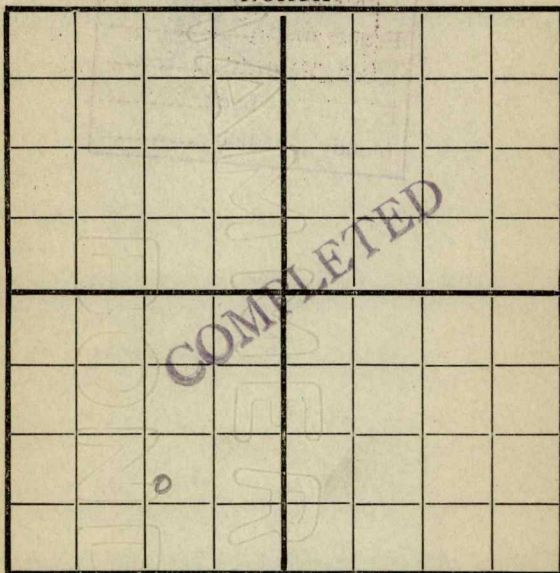

SOUTH

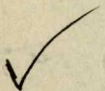Location ☒ 798.5Rig up 1409 WDrilling and Remarks: 12215

RECORD

Cased _____ in., _____ ft.

Sand _____

Gas _____

Oil _____

Total Depth _____

PRODUCTION

1st 24 hrs. Nat. _____

1st 24 hrs. after shot _____

Gas _____ Cu. Ft.

Dry Hole _____

Abandoned ☒

Date

10/3 1918 Pyle Scout

Map No. K14 Sec. 31 Twp. 25 R. 5Well No. 46 AdamoEmpire Company

Contractor

NORTH

WEST

EAST

FIRST REPORT

O

SOUTH

Location 798-SRig up 1409-W

Drilling and Remarks:

120' ✓

RECORD

Cased _____ in., _____ ft.

Sand _____

Gas _____

Oil _____

Total Depth _____

PRODUCTION

1st 24 hrs. Nat. _____

1st 24 hrs. after shot _____

Gas _____ Cu. Ft.

Dry Hole _____

Abandoned _____

Date

191

8

Pyle

Scout


Map No. _____ Sec. 31 Twp. 25 R. 5Well No. 46 AdamsEngine _____ Company _____

_____ Contractor _____

NORTH

WEST

EAST

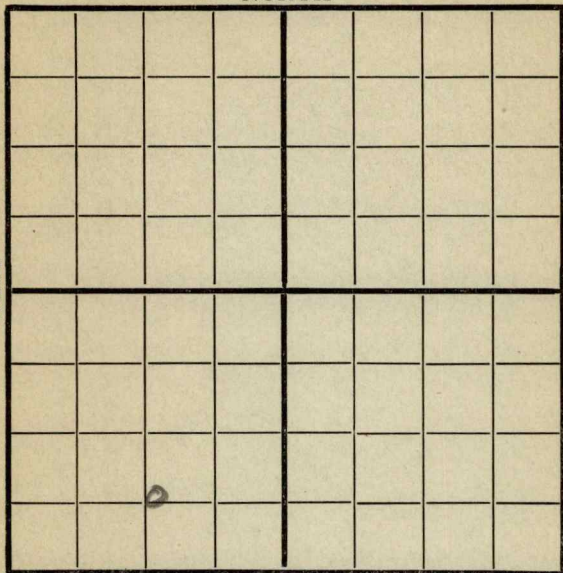

SOUTH

RECORD

Location _____

Cased _____ in., _____ ft.

Rig up _____

Sand _____

Drilling and Remarks:

Gas _____

Oil _____

Total Depth _____

PRODUCTION

1st 24 hrs. Nat. _____

1st 24 hrs. after shot _____

Gas _____ Cu. Ft.

Dry Hole _____

Abandoned _____

Date


10/26 1918 Office Scout

Map No. K 14 Sec. 31 Twp. 25 R. 5Well No. 46 AdamsEmpire Company

Contractor

NORTH

WEST

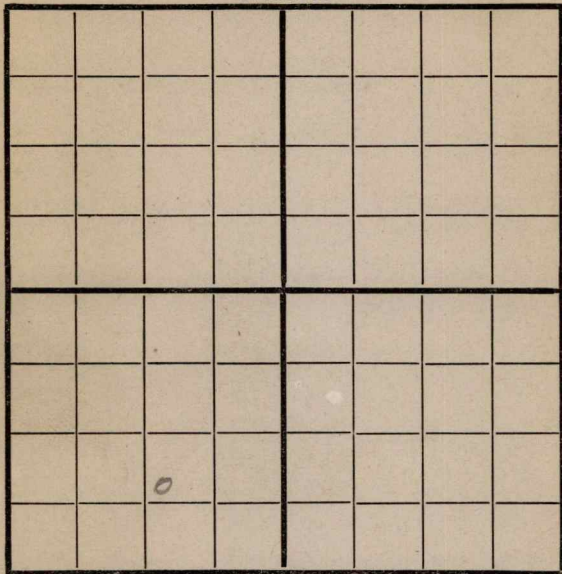

EAST

SOUTH

Location 798-S1409-V

Rig up

Drilling and Remarks:

1900'

RECORD

Cased _____ in., _____ ft.

Sand _____

Gas _____

Oil _____

Total Depth _____

PRODUCTION

1st 24 hrs. Nat. _____

1st 24 hrs. after shot _____

Gas _____ Cu. Ft.

Dry Hole _____

Abandoned _____

Date

11/71918

Pyle

Scout

Map No. K 14 Sec. 31 Twp. 25 R. 5Well No. 46 AdamsEmpire Company

Contractor

NORTH

WEST

EAST



SOUTH

Location 798-5Rig up 1239-5

Drilling and Remarks:

RECORD

Cased _____ in., _____ ft.

Sand 2440-2464

Gas _____

Oil _____

Total Depth _____

PRODUCTION

1st 24 hrs. Nat. 160 bbls

1st 24 hrs. after shot _____

Gas _____ Cu. Ft.

Dry Hole _____

Abandoned _____

Date

11/21 191 8 Pyle Scout