


Section 6 Township 24 Range 5E

Well No. #1 Arthur

Company Rex & Morris

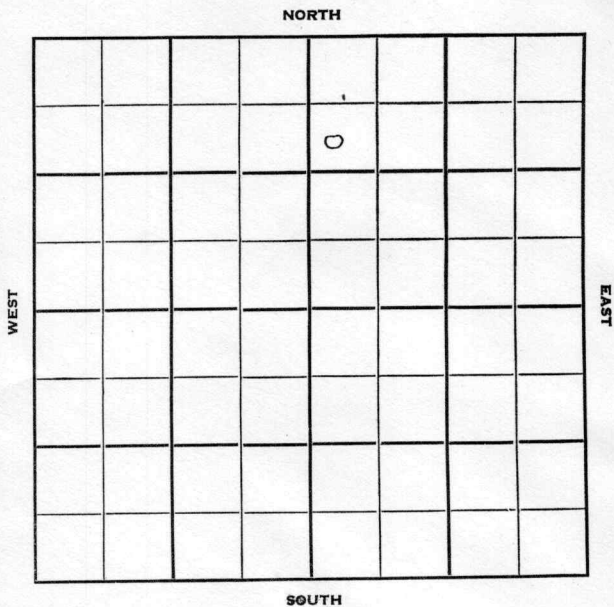

Butler

KANSAS

Sec. 6 Twp. 24 R. 5E

Well No. #1 Arthur Farm
Rex & Morris Company
Rex & Morris - Contr. Contractor


990' Ft. from N. Line

 Ft. from S. Line

 Ft. from E. Line

330' Ft. from W. Line

SW NW NE

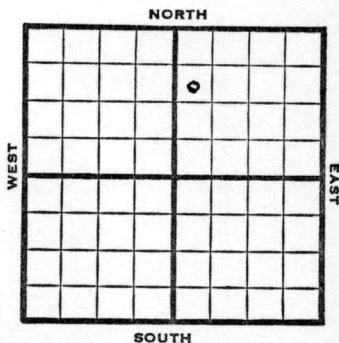

1951

Elev. 1459' REPORT

9/5

Oil Well TD 2458
Miss 2447-48
5½" @ 2448' TD 2458
FU 1200' oil Comp. 35 BOPD

**FIRST REPORT
COMPLETED**

J. E. TYRA