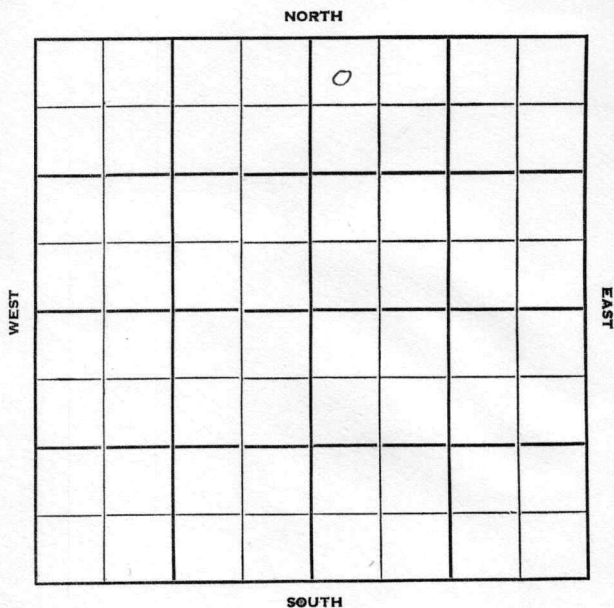


Section 6 Township 24 Range 5EWell No. #2 ArthurCompany Rex & Morris

Butler

Sec. 6 Twp. 24 R. 5 E

Well No. # 2 Arthur Farm

Rex & Morris

Company

Rex & Morris

Contractor


330 Ft. from N. Line

 Ft. from S. Line

 Ft. from E. Line

330 Ft. from W. Line

NW NW NE

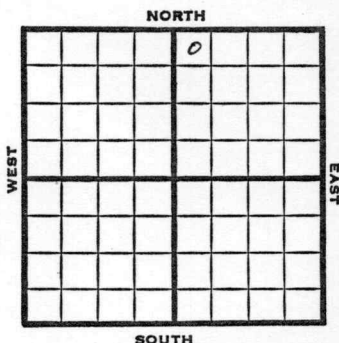

1951

Elev. -

REPORT

9/5

Location

10/3

Oil well TD 2509' 8" @ 106'
Cong. 2441' Miss 2468'
TD 2470' 5" @ 2469' TD 2509'
water. PB 2477' Hydrofrac
S/9 BOPH
Comp. 35 BOPD

COMPLETED

J. E. TYRA

County Butler State Kansas
 Sec. 6 (^{Blk.}_{Twp.}) 24 (^{Sur.}_{Rge.}) 5E Map No. _____
 Operator Rex & Morris
 Well No. 2 Farm Arthur
 Elev. _____ Location NW NW NE

				0			

330 Ft. From N Line NE
 330 Ft. From W Line Quarter

1st. Report _____

Completion OCT 3 1951

Remarks _____

Rex & Morris - Contr.

Spudding Date _____

Drlg. Data Oil well TD 2509

8" @ 106 Cong. 2441 Miss. 2468

TD 2470 5" @ 2469 TD 2509 water

PB 2477 Hydrofrac S/ 9 boph

Comp. 35 bopd