
FORM 51 25M 8-50 WESTERN Butler KANSAS

Section 6 Township 24 Range 5E

Well No. #6 Arthur

Company Rex & Morris

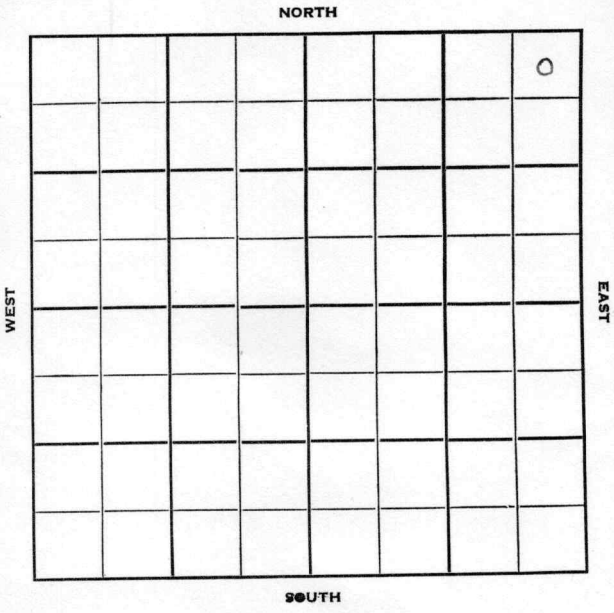

FORM 252-B
10M 10-50 PETROL

Butler KANSAS

Sec. 6 Twp. 24 R. 5E ✓

Well No. #6 Arthur Farm

Rex & Morris Company

Contractor


330' Ft. from N. Line

Ft. from S. Line

330' Ft. from E. Line

Ft. from W. Line

NE NE NE

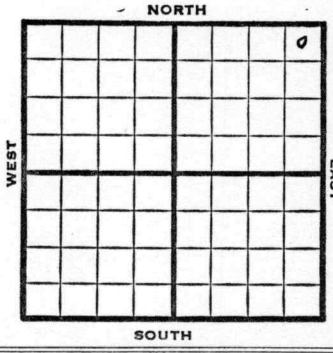

1951	REPORT
	Elev. 1483'
11/14	Set Surf.
12/19	D & A TD 2665' 8" @ 105' Miss 2520' Viola 2644' TD 2665' D & A

ABANDONED

FORM 275 FOR SALE BY KANSAS BLUE PRINT CO.


County Butler State Kansas

Sec. 6 (Blk. Twp.) 24 (Sur. Rge.) 5E Map No.

Operator Rex & Morris

Well No. 6 Farm Arthur

Elev. Location NE NE NE

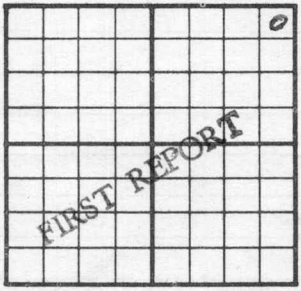

330 Ft. From N Line NE

330 Ft. From E Line Quarter

1st. Report NOV 14 1951

Completion

Remarks

Spudding Date

Drlg. Data

Set Surf.

J. E. TYRA

FORM 275 FOR SALE BY KANSAS BLUE PRINT CO.


County Butler State Kansas

Sec. 6 (Blk. Twp.) 24 (Sur. Rge.) 5E Map No.

Operator Rex & Morris

Well No. 6 Farm Arthur

Elev. 1483 Location NE NE NE

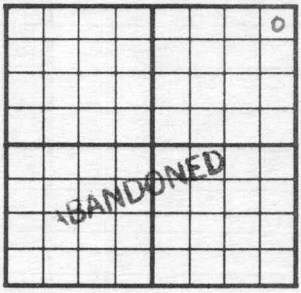

330 Ft. From N Line NE

330 Ft. From E Line Quarter

1st. Report

Completion DEC 19 1951

Remarks

Spudding Date

Drlg. Data D & A TD 2665

8" @ 105 Miss. 2520 Viola 2644

TD 2665

D & A

J. E. TYRA