


Section 27 Township 25 Range 5E

Well No. 1 J. H. Mills "B"

Company Molk Petr.

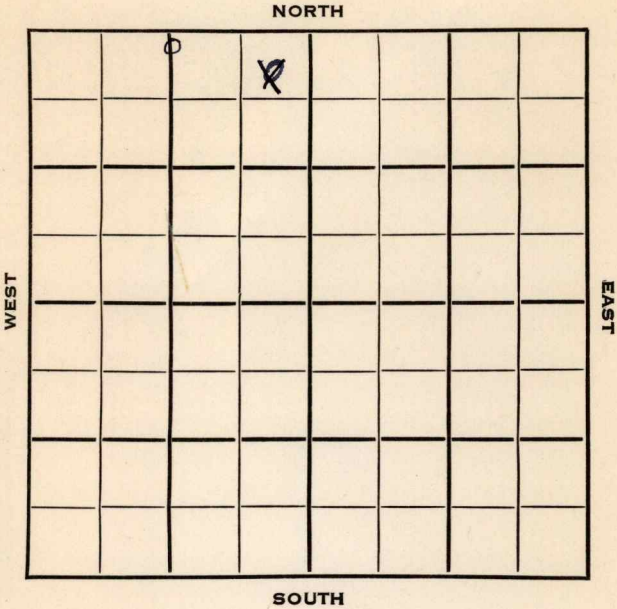

Butler

KANSAS

SEC.

TWP.

R.

27

25

5E

WELL NO.

#1 J.H. Mills "B"

FARM

COMPANY

Molk Petroleum

CONTRACTOR

Molk Pet.

Eldorado Pool

330


Ft. from N. Line

Ft. from S. Line

Ft. from E. Line

Ft. from W. Line

NORTH

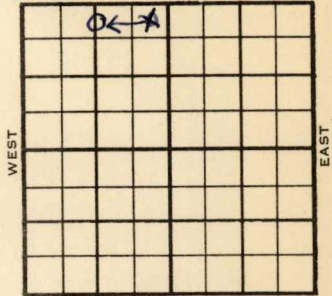

1320
~~330~~

c N 1/2 N 1/2
~~NE NE NW~~

1954

ELEVATION

1353'

REPORT

3/17

Spud 3-12-54

15 1/2" @ 27'

Drlg 500'

4/14

Spud 3-12-54

Oil Well

TD 2450'

15 1/2" @ 27'

12" @ 755'

Lans 1690', KC 1935'

8" @ 1935'

Wilcox 2443'

TD 2450'

FU 150' oil 1/2 hrs.

7" @ 2443'

Comp. 25 bopd

Wilcox Test.

COMPLETED

County **Butler** State **Kansas**Sec. **27** (Blk.) **25** (Sur.) **5E** Map No.Operator **Molk Petroleum**Well No. **1** Farm **J. H. Mills "B"**Elev. Location **NE NE NW**

FIRST REPORT

330 Ft. From **N** Line **NW****330** Ft. From **E** Line Quarter1st. Report **MAR 17 1954**

Completion

Remarks **Wilcox test****Molk Pet. - Contr.**Spudding Date **3-12-54**Drlg. Data **Eldorado Pool****15½" @ 27 drlg. 500**

J. G. McGEHEE

Kansas

Map No. _____ Sec. 27 Twp. 25 R. 5EWell No. 1 J. H. Mills "B"

Molk Pet.

Company _____

CORRECTION

Contractor _____

C $N\frac{1}{2}$ $N\frac{1}{2}$ NW

SECTION PLAT


330 Ft. from N. Line

_____ Ft. from S. Line

1320 Ft. from E. Line

_____ Ft. from W. Line

Butler County

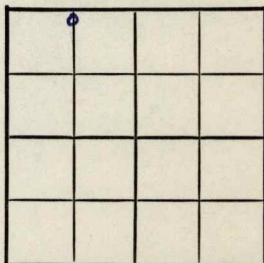

Location _____

Rig up _____

Drilling and Remarks:

Reported

NE NE NW

RECORD

Cased _____ in., _____ ft.

Sand _____

Gas _____

Oil _____

Total Depth _____

PRODUCTION

1st 24 hrs. Nat. _____

1st 24 hrs. after shot _____

Gas _____ Cu. Ft.

Dry Hole _____

Abandoned _____

Date

MAR 31 1954 19

J. G. McGEHEE

Scout

J. G. McGEHEE