
FORM 51

Butler KANSAS

Section 28 Township 25 Range 5E

Well No. #118 Hegberg

Company Cities Service

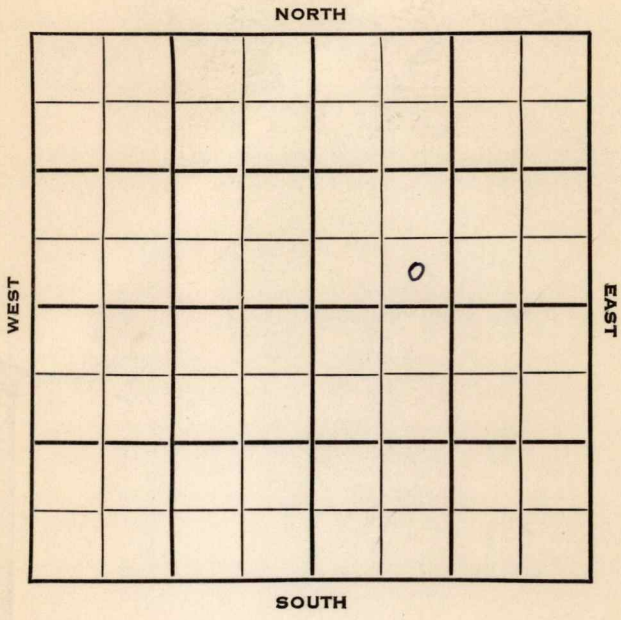

FORM 252-B

Butler KANSAS

Sec. 28 Twp. 25 R. 5 E

Well No. # 118 Hegberg Farm

Cities Service Company

Contractor


Ft. from N. Line

330 Ft. from S. Line

Ft. from E. Line

990 Ft. from W. Line

SE SW NE

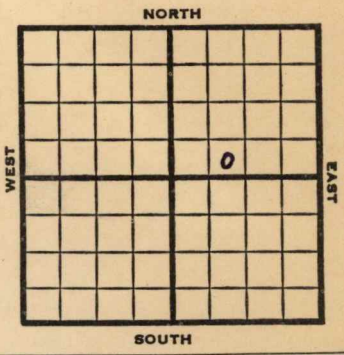

1953	REPORT
9/2	Elev. 1374' Oil well TD 2558' Lan Lans 1678 KC 1972 B KC 2142' Viola 2441 Simp. 2478 Arb. 2552' TD 2554' 5" @ 2552 DD 2558 FU 1088' wtr. 4 hr. PB 2520' 15/2479-84 FU 900' wtr. PB 2470 15/2442-47 ½ BO 45 BWPH CO to 2407' 8/2459-60 3 BO 67 BW 2 hr. Co to 2460 24/2442-46 Comp. 50 BOPD FIRST REPORT COMPLETED

FORM 275 FOR SALE BY KANSAS BLUE PRINT CO.

County Butler State Kansas

Sec. 28 (Blk. Twp.) 25 (Sur. Rge.) 5E Map No.

Operator Cities Service

Well No. 118 Farm Hegberg

Elev. 1374 Location SE SW NE



330 Ft. From S Line NE

990 Ft. From W Line Quarter

1st. Report SEP 2 1953

Completion SEP 2 1953

Remarks

Spudding Date

Drlg. Data Oil well TD 2558

Lans. 1678 KC 1972 B KC 2142

Viola 2441 Simp. 2478 Arb. 2552

TD 2554 5" @ 2552 DD 2558 FU 1088'

wtr. 4 hr. PB 2520 15/ 2479-84

FU 900' wtr. PB 2470 15/ 2442-47

½ bo 45 bwph CO to 2407 8/ 2459-60

3 bo 67 bw 2 hr. CO to 2460 24/ 2442-46 Comp. 50 bopd

J. G. Moore