

**KANSAS**

Butler

Section 21 Township 27 Range 4E

Well No. 7 Loomis


Company Rex & Morris

Misc.

NORTH

WEST

EAST

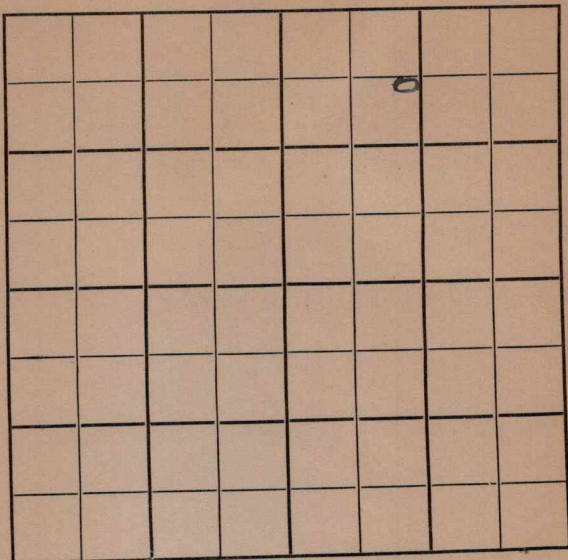

SOUTH

Butler

KANSAS

Sec. 21 Twp. 27 R. 4E

Well No. #7 Loomis Farm

Rex & Morris

Company

Miscellaneous (Rex & Morris, Cont.)


685' Ft. from N. Line

         Ft. from S. Line

         Ft. from E. Line

1015' Ft. from W. Line

C E L NW NE

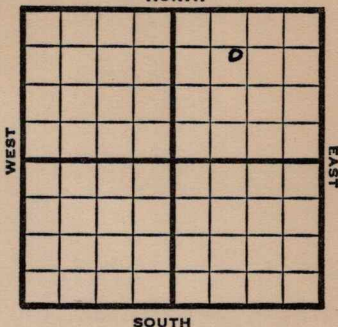

1949

**Lev 1226'**

REPORT

8/31 660 run 12"

9/7 10" @ 656'

8" @ 1270'

Drlg. 1670'

9/14 Drlg 2240'

9/21 "

9/28 **Arb. 2341'**

7" @ 2342'

TD 2347'

10/5 5000 acid

10/12 TD 2347'

**Arb. 2341'**

7" @ 2342'

500 acid

Pump 25 Oil Pot

38° Gr.

Comp

**COMPLETED**

Map No. \_\_\_\_\_ Sec. 21 Twp. 27 R. 4E

Well No. 7 Loomis

Rex & Morris Company

Rex & Morris Contractor

C E L NW NE


FIRST REPORT  
SECTION PLAT

685 Ft. from N. Line

\_\_\_\_\_ Ft. from S. Line

\_\_\_\_\_ Ft. from E. Line

1015 Ft. from W. Line

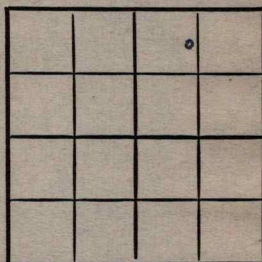

Butler County

Location \_\_\_\_\_

Rig up \_\_\_\_\_

Drilling and Remarks:

660 run 12"

RECORD

Cased \_\_\_\_\_ in., \_\_\_\_\_ ft.

Sand \_\_\_\_\_

Gas \_\_\_\_\_

Oil \_\_\_\_\_

Total Depth \_\_\_\_\_

PRODUCTION

1st 24 hrs. Nat. \_\_\_\_\_

1st 24 hrs. after shot \_\_\_\_\_

Gas \_\_\_\_\_ Cu. Ft.

Dry Hole \_\_\_\_\_

Abandoned \_\_\_\_\_

Date

AUG 31 1949 19

S. J. LEWIS

Scout



Map No. \_\_\_\_\_ Sec. 21 Twp. 27 R. 4E

Well No. 7 Loomis

Rex & Morris Company

COMPLETE Contractor

C E L NW NE

E 1/2 226  
SECTION PLAT

685 Ft. from N. Line

\_\_\_\_\_ Ft. from S. Line

\_\_\_\_\_ Ft. from E. Line

1015 Ft. from W. Line

|  |  |  |  |
|--|--|--|--|
|  |  |  |  |
|  |  |  |  |
|  |  |  |  |
|  |  |  |  |
|  |  |  |  |

Butler County

Location \_\_\_\_\_

Rig up \_\_\_\_\_

Drilling and Remarks:

*Ar 2341*

*7' 02342*

*500 acid*

*Pump 25 oil*

*500 gr*

RECORD

Cased \_\_\_\_\_ in., \_\_\_\_\_ ft.

Sand \_\_\_\_\_

Gas \_\_\_\_\_

Oil \_\_\_\_\_

Total Depth 2347

PRODUCTION

1st 24 hrs. Nat. \_\_\_\_\_

1st 24 hrs. after shot \_\_\_\_\_

Gas \_\_\_\_\_ Cu. Ft.

Dry Hole \_\_\_\_\_

Abandoned \_\_\_\_\_

Date

OCT 12 1949

19

S. J. LEWIS

Scout