


Map No. Kansas Sec. 28 Twp. 25 R. 5
Well No. 32 Stokes Farm
Empire G & F Company

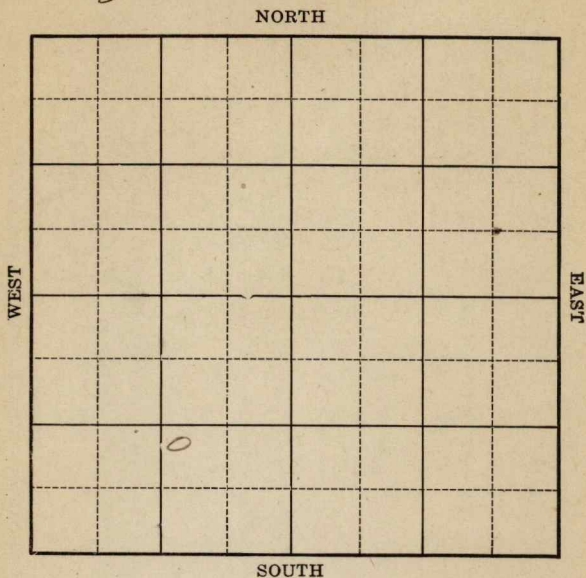

Location _____

Drilling Remarks _____

Rig Up _____

Drilling Remarks _____

RECORD

Cased _____ in. _____ ft.

Sand _____

Gas _____

Oil _____

Total Depth _____

PRODUCTION

1st 24 hrs. Nat. _____

1st 24 hrs. after shot _____

Gas _____ cu. ft.

Dry Hole _____

Abandoned _____

Butler Co

Map No. Kansas Sec. 28 Twp. 25 R. 5

Well No. 32 Stokes Farm


Empire L. & F. Company

NORTH

WEST

EAST

SOUTH

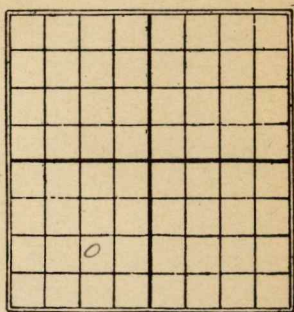

_____ Ft. from N. Line

1120 Ft. from S. Line

1120 Ft. from E. Line

_____ Ft. from W. Line

Date

REPORT

1926

3/25

Rigging up

4/1

Spudding

4/7

J.D. 200

4/14

Drill 500

4/21

LD-630-645-J.D. 650

15/10 B13ls.

Map No. **K14 KANSAS** Sec. **28** Twp. **25** R. **5**

Well No. **32 Stores**
En Air 5270 Company _____

Contractor _____

FIRST REPORTS

SECTION PLAT

_____ Ft. from N. Line

1120 _____ Ft. from S. Line

1120 _____ Ft. from E. Line

_____ Ft. from W. Line

Location _____

Rig up _____

Drilling and Remarks:

Rigging up

RECORD

Cased _____ in., _____ ft.

Sand _____

Gas _____

Oil _____

Total Depth _____

PRODUCTION

1st 24 hrs. Nat. _____

1st 24 hrs. after shot _____

Gas _____ Cu. Ft.

Dry Hole _____

Abandoned _____

Date

MAR 25 1926

CHAS. L. SHERWOOD

192

Scout

K/4 KANSAS

Map No. _____ Sec. 28 Twp. 25 R. 5

Well No. 32 Stokess

Company _____

Contractor _____

COMPLETED

SECTION PLAT

_____ Ft. from N. Line

1120 _____ Ft. from S. Line

1120 _____ Ft. from E. Line

_____ Ft. from W. Line

	o		

Location _____

Rig up _____

Drilling and Remarks:

15710 Bb.

RECORD

Cased _____ in., _____ ft.

Sand 630-645

Gas _____

Oil _____

Total Depth 650

PRODUCTION

1st 24 hrs. Nat. _____

1st 24 hrs. after shot _____

Gas _____ Cu. Ft.

Dry Hole _____

Abandoned _____

Date

APR 21 1926

192 _____ Scout

CHAS. L. SHERWOOD