

KANSAS

FORM 51 IOM 12-46 PETROL

Butler County

Section 28 Township 25 Range 5E

Well No. 37
36 Stokes


Company Cities Service

Miscellaneous

NORTH

WEST

EAST

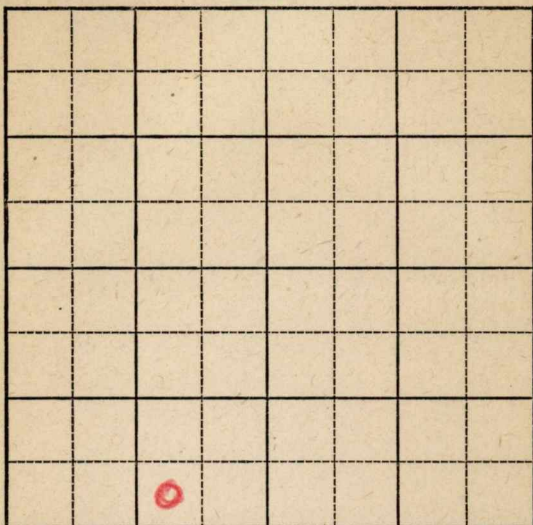

SOUTH

KANSAS

Butler



Sec. 28 Twp. 25 R. 5-E

Well No. 37 ~~186~~ Stokes Farm

Cities Service Company

Miscellaneous

 Ft. from N. Line

330


 Ft. from S. Line

990

 Ft. from E. Line

 Ft. from W. Line

SW SE SW

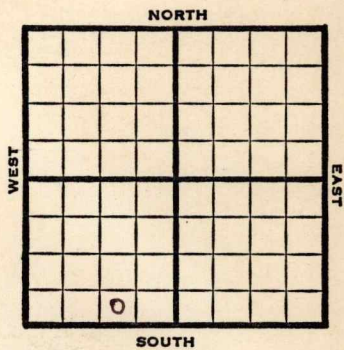

1947

Elev 1388'

REPORT

7/2

Location

7/8

"

7/16

Drlg 100'

7/22

KC 1970
Drlg. 2016

7/29

Viola 2421'
Simpson sand 3425'
Drlg 2440'

8/6

Arbuckle 2452'
5" @ 2452'
TD 2454'
Pump 42 bbls oil 12 hrs.

8/13

Arb. 2452'
5" @ 2452'
Pump 65 oil / 10 W Pot.
Gr. 38
T.D. 2454'
Complete

COMPLETED

Map No. _____ Sec. 28 Twp. 25 R. 5E

Well No. 36 Stokes

Cities Service Company

FIRST REPORT

Contractor

SW SE SW

SECTION PLAT

_____ Ft. from N. Line

330 Ft. from S. Line

990 Ft. from E. Line

_____ Ft. from W. Line

Butler County

Location X

Rig up _____

Drilling and Remarks:

RECORD

Cased _____ in., _____ ft.

Sand _____

Gas _____

Oil _____

Total Depth _____

PRODUCTION

1st 24 hrs. Nat. _____

1st 24 hrs. after shot _____

Gas _____ Cu. Ft.

Dry Hole _____

Abandoned _____

Date

JUL 2 1947 19

S. J. LEWIS Scout

Map No. 14 Sec. 28 Twp. 25 R. 5E

Well No. 37 Stokes

Cities Service Company

CORRECTION Contractor

SW SE SW


SECTION PLAT

 Ft. from N. Line

330 Ft. from S. Line

990 Ft. from E. Line

 Ft. from W. Line

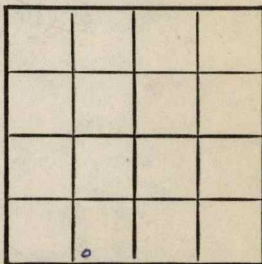

Butler County

Location

Rig up

Drilling and Remarks:

Reported

#36 Stokes

RECORD

Cased in., ft.

Sand

Gas

Oil

Total Depth

PRODUCTION

1st 24 hrs. Nat.

1st 24 hrs. after shot

Gas Cu. Ft.

Dry Hole

Abandoned

Date

JUL 16 1947 19 S. J. LEWIS Scout

Kansas

Map No. 14 Sec. 28 Twp. 25 R. 5EWell No. 37 Stokes


Cities Service

Company

COMPLETE

Contractor

SW SE SW

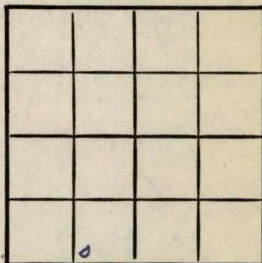E. 1. 188
SECTION PLAT Ft. from N. Line330 Ft. from S. Line990 Ft. from E. Line Ft. from W. Line

Butler County

Location Rig up

Drilling and Remarks:

*Per 2452**5" @ 2452**Prop 65 oil + 10W*
*BT**35° SW*

RECORD

Cased in., ft.Sand Gas Oil Total Depth 2454

PRODUCTION

1st 24 hrs. Nat. 1st 24 hrs. after shot Gas Cu. Ft.Dry Hole Abandoned

Date

AUG 13 1947

19

S. J. LEWIS

Scout