

KANSAS

Butler


FORM 51 IOM 12-46 PETROL

Section 28 Township 25 Range 5-E

Well No. 38 Stokes

Company Cities Service

Miscellaneous NORTH

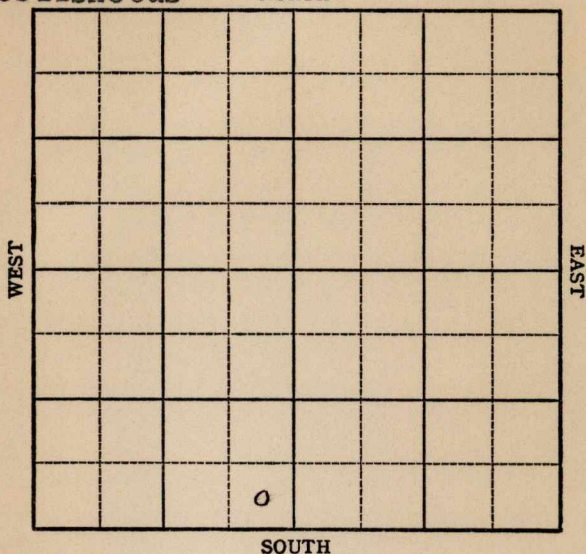

KANSAS

Butler

Sec. 28 Twp. 25 R. 5E

Well No. #38 Stokes Farm

Cities Service Company

Misc.


 Ft. from N. Line

330 Ft. from S. Line

330 Ft. from E. Line

 Ft. from W. Line

SE SW

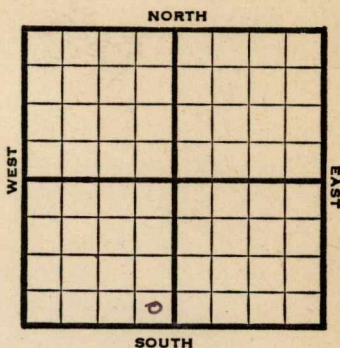

1947

Elev. 1384' REPORT

9/24

Drlg. 2310'

10/1

Lansing 1678'
KC 1981'
Simpson 2432'
Arbuckle 2409'
TD 2471'
7" @ 2469'
1525' water & 480' oil

10/8

Pump 12 bbls oil & 140 W
in 24 hrs.

10/15

"

10/22

Arbuckle 2469'
7" @ 2469'
Pump 15 oil & 65 W Pot
Gr. 380
Total Depth 2471'

COMPLETED

Map No. _____ Sec. 28 Twp. 25 R. 5E

Well No. 38 Stokes

Cities Service Company

FIRST REPORT

Contractor

SE SW

SECTION PLAT

_____ Ft. from N. Line

330 Ft. from S. Line

330 Ft. from E. Line

_____ Ft. from W. Line

Butler County

Location _____

Rig up _____

Drilling and Remarks:

drlg. 2310

RECORD

Cased _____ in., _____ ft.

Sand _____

Gas _____

Oil _____

Total Depth _____

PRODUCTION

1st 24 hrs. Nat. _____

1st 24 hrs. after shot _____

Gas _____ Cu. Ft.

Dry Hole _____

Abandoned _____

Date

SEP 24 1947 19

S. J. LEWIS Scout

Map No. 14 Sec. 28 Twp. 25 R. 5E

Well No. 38 Stokes

Cities Service


Company

COMPLETE

Contractor

SE SW

E 1, 1384
SECTION PLAT

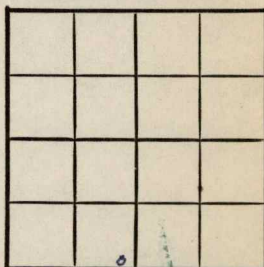

 Ft. from N. Line

330 Ft. from S. Line

330 Ft. from E. Line

 Ft. from W. Line

Butler County

Location

Rig up

Drilling and Remarks:

CR 2469
7" @ 2469
Run Oil +
65 N.D.D.

38-2-9

RECORD

Cased in., ft.

Sand

Gas

Oil

Total Depth 2471

PRODUCTION

1st 24 hrs. Nat.

1st 24 hrs. after shot

Gas Cu. Ft.

Dry Hole

Abandoned

Date

OCT 22 1947 19 S. J. LEWIS Scout