

KANSAS

Well No. #40 Stokes

Company Cities Service

NORTH

WEST

EAST

0

SOUTH

Butler

KANSAS

Sec. 28 Twp. 25 R. 5 E

Well No. # 40 Stokes Farm

Cities Service

Company

Contractor


990 Ft. from N. Line

Ft. from S. Line

Ft. from E. Line

330 Ft. from W. Line

SW NW SW

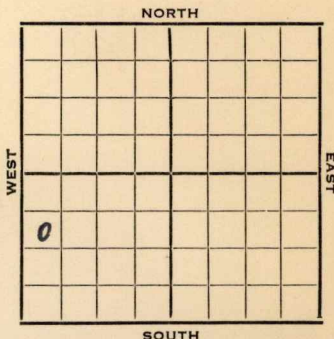

1953

Elev. 1386'

REPORT

7/22

Oil well TD 2582' 8" @ 94
 Lans 1692 KC 1987 B KC 2158
 Viola 2443 Simp 2464 Arb. 2537
 TD 2539 5" @ 2538 DD 2582 PB 2540
 5/2535-37 1 BWPH PB 2524 47/2464-
 72 12 BO 12 BW 17 hrs. PB 2463'
 46/2443-54 500 A
 Comp. 69 BOPD 85 BW

FIRST REPORT
 COMPLETED

Comp. 69 bopd 85 bw