


Map No. _____ Sec. 1 Twp. 26 R. 4
Well No. #1 abandoned Farm _____
Empire Company

NORTH

WEST

EAST

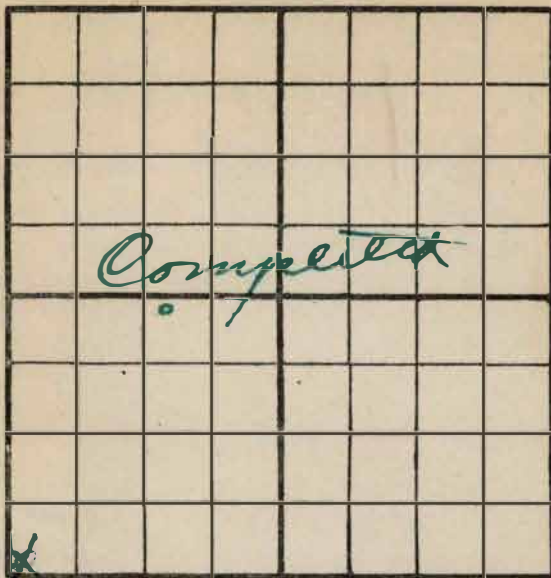

SOUTH

Location _____

Rig Up _____

Drilling Remarks:

Drilling Remarks:

350 Bae -

7/67/18

24 2428

RECORD

PRODUCTION

Cased _____ in. _____ ft.

1st 24 hrs. Nat. _____

Sand _____

1st 24 h.s. after shot _____

Gas _____

Gas _____ cu. ft

Oil _____

Dry Hole _____

Total Depth _____

Abandoned _____

Map No. _____ Sec. 1 Twp. 26 R. 4
 Well No. 1 Abraham Farm
Corp. Company

NORTH

WEST

EAST

SOUTH

Location _____

Rig up. ✓

Drilling and remarks:

RECORD

Cased _____ in. _____ Ft.

Sand _____

Gas _____

Oil _____

Total Depth _____

PRODUCTION

1st 24 hrs. Nat. _____

1st 24 hrs. after shot _____

Gas _____ Cu. Ft.

Dry Hole _____

Abandoned _____

Date JUN 30 1917

, 191

G. T. Crocker Scout

Map No. _____ Sec. 1 Twp. 26 R. 4

Well No. 1 Abraham Farm

_____ Emp. Company

NORTH

WEST EAST

SOUTH

Location _____

Rig up ☒

Drilling and remarks:

RECORD

Cased _____ in. _____ Ft.

Sand _____

Gas _____

Oil _____

Total Depth _____

PRODUCTION

1st 24 hrs. Nat. _____

1st 24 hrs. after shot _____

Gas _____ Cu. Ft.

Dry Hole _____

Abandoned _____

Date


JUL 7 1917; 191 C. J. Crocker Scout

Map No. _____ Sec. 1 Twp. 26 R. 4
 Well No. 1 Abraham Farm _____
Emp. Company _____

NORTH

WEST

EAST

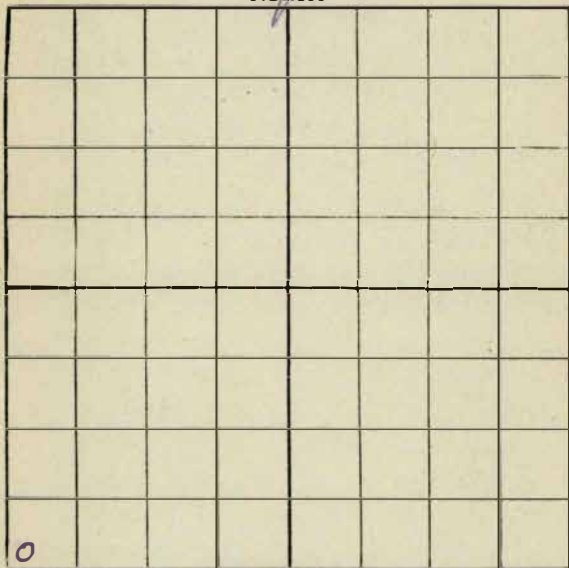

SOUTH

Location _____

Rig up _____

Drilling and remarks:

Rig up

RECORD

Cased _____ in. _____ Ft.

Sand _____

Gas _____

Oil _____

Total Depth _____

PRODUCTION

1st 24 hrs. Nat. _____

1st 24 hrs. after shot _____

Gas _____ Cu. Ft.

Dry Hole _____

Abandoned _____


Date

JUL 14 1917

C. J. Crocker
 Scout

Map No. _____ Sec. 1 Twp. 26 R. 4Well No. 1000 Farm _____Company Angine

NORTH

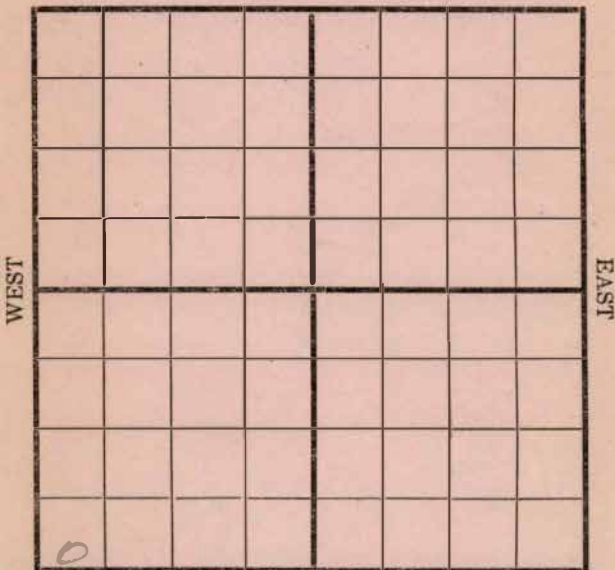

SOUTH

Location _____

Rig Up _____

Drilling and remarks

690

RECORD

Cased _____ in. _____ Ft.

Sand _____

Gas _____

Oil _____

Total Depth _____

PRODUCTION

1st 24 hrs. Nat. _____

1st 24 hrs. after shot _____

Gas _____ Cu. Ft.

Dry Hole _____

Abandoned _____

Date


8/1, 1917 Carney Scout

Map No. _____ Sec. 1 Twp. 26 R. 4
 Well No. 1 Abresham Farm _____
Empire Company

NORTH

WEST

EAST

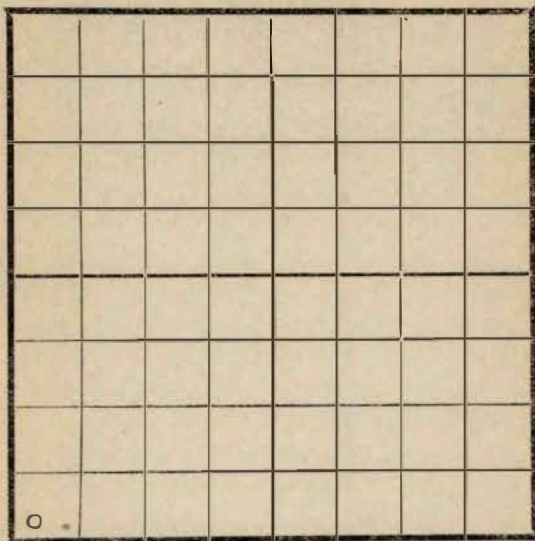

SOUTH

Location _____
 Rig Up _____
 Drilling and remarks

1140

RECORD •

Cased _____ in _____ Ft.
 Sand _____
 Gas _____
 Oil _____
 Total Depth _____

PRODUCTION

1st 24 hrs. Nat. _____
 1st 24 hrs. after shot _____
 Gas _____ Cu. Ft.
 Dry Hole _____
 Abandoned _____

Date


8/9, 1917 Condyff Scout

Map No. _____ Sec. 1 Twp. 26 R. 4Well No. 1. Abraham Farm _____Empire Company _____

NORTH

WEST

EAST

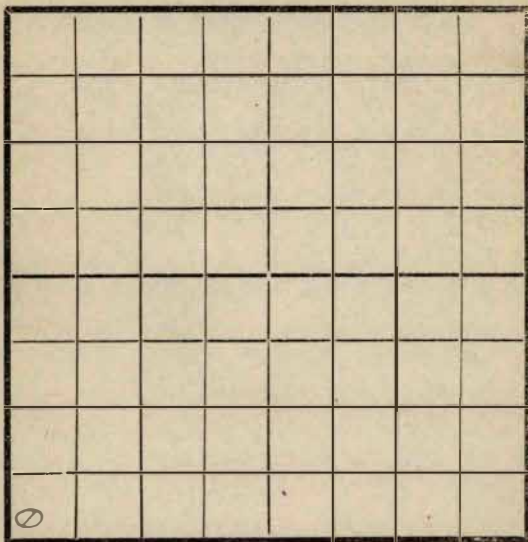

SOUTH

Location _____

Rig Up _____

Drilling and remarks

at 1550.

RECORD

Cased _____ in _____ Ft.

Sand _____

Gas _____

Oil _____

Total Depth _____

PRODUCTION

1st 24 hrs. Nat. _____

1st 24 hrs. after shot _____

Gas _____ Cu. Ft.

Dry Hole _____

Abandoned _____

Date


8-23, 1917 Lang Scout

Map No. _____ Sec. 1 Twp. 26 R. 4
Well No. 1 Abraham Farm _____
Empire Company

NORTH

WEST

EAST

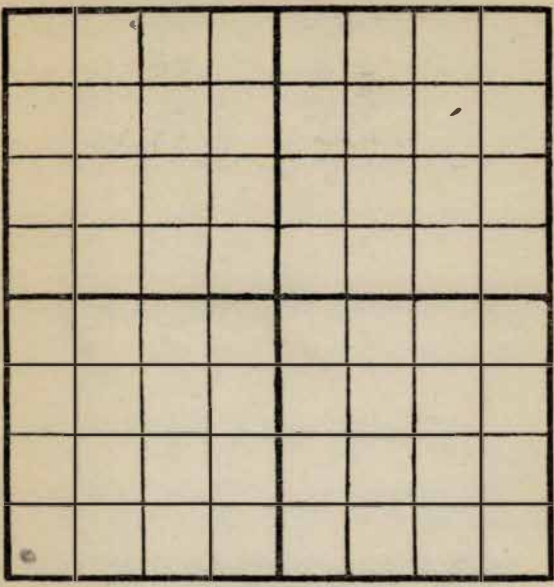

SOUTH

Location _____
Rig Up ✓ _____
Drilling and remarks
Shut Down
1770

RECORD

Cased _____ in. _____ Ft.
Sand _____
Gas _____
Oil _____
Total Depth _____

PRODUCTION

1st 24 hrs. Nat. _____
1st 24 hrs. after shot _____
Gas _____ Cu. Ft.
Dry Hole _____
Abandoned _____


Date 10/9, 1917, Condy Scout

Map No. _____ Sec. 1 Twp. 26 R. 4Well No. 1 Abolomon Farm
Economy Company

NORTH

WEST

EAST

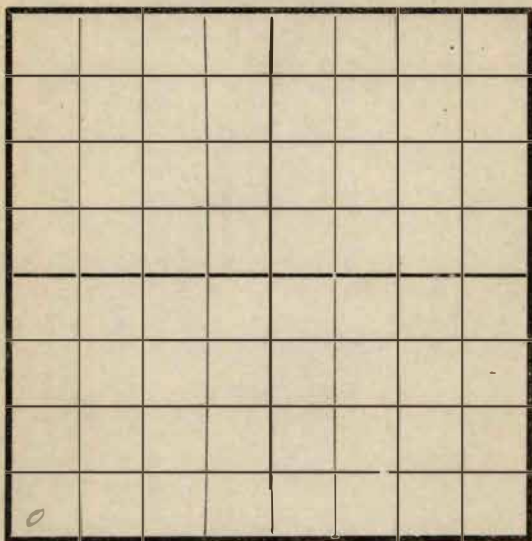

SOUTH

Location _____

Rig Up _____

Drilling and remarks

Top sand
2372'

Shut down
for water

RECORD

Cased _____ in. _____ Ft.

Sand _____

Gas _____

Oil _____

Total Depth _____

PRODUCTION

1st 24 hrs. Nat. _____

1st 24 hrs. after shot _____

Gas _____ Cu. Ft.

Dry Hole _____

Abandoned _____

Date

10/17, 191 *7* *Conkey* Scout


Map No. _____ Sec. 1 Twp. 26 R. 4

Well No. 10674 Farm _____
Empire Company

NORTH

WEST

EAST

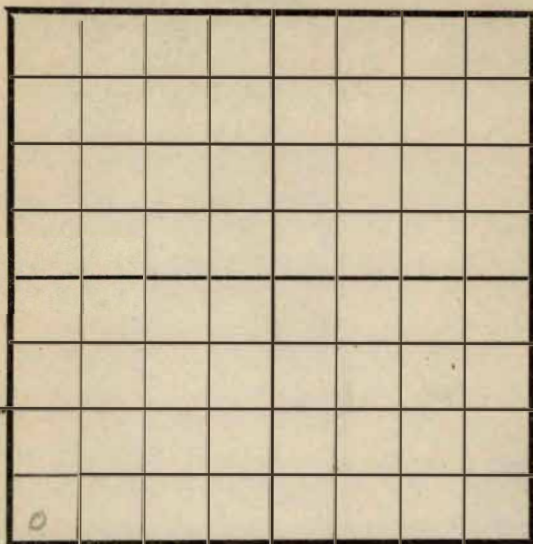

SOUTH

RECORD

Location _____

Rig Up _____

Drilling and remarks

Cased _____ in. _____ Ft.

Sand _____

Gas _____

Oil _____

Total Depth _____

PRODUCTION

1st 24 hrs. Nat. _____

1st 24 hrs. after shot _____

Gas _____ Cu. Ft.

Dry Hole _____

Abandoned _____


Date

10/14 1917 Empire Scout

Map No. _____ Sec. 1 Twp. 26 R. 4Well No. 1 Abraham FarmEngine Company

NORTH

WEST

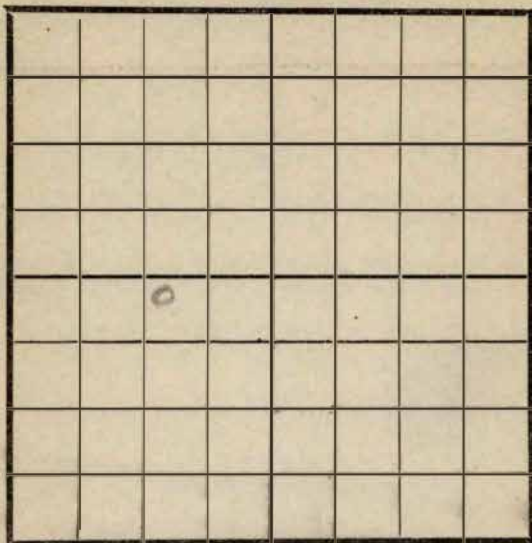

EAST

SOUTH

Location _____

Rig Up _____

Drilling and remarks

Rigging up

RECORD

Cased _____ in. _____ Ft.

Sand _____

Gas _____

Oil _____

Total Depth _____

PRODUCTION

1st 24 hrs. Nat. _____

1st 24 hrs. after shot _____

Gas _____ Cu. Ft.

Dry Hole _____

Abandoned _____

Date

11/21, 1917 Carroll Scout


Map No. _____ Sec. 1 Twp. 26 R. 4

Well No. 1 Abraham Farm _____

Engine Company _____

NORTH

WEST

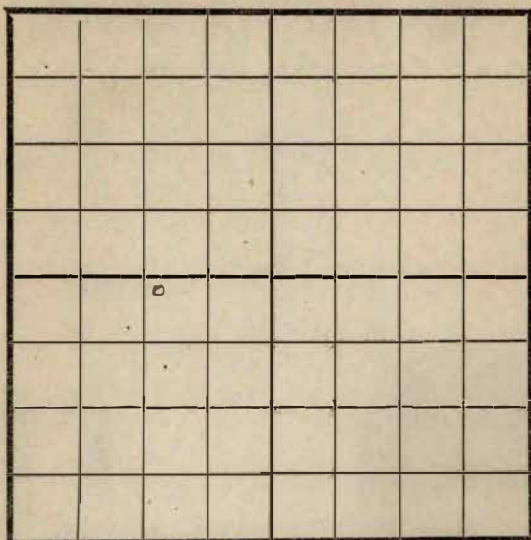

EAST

SOUTH

Location _____

Rig Up ☒ _____

Drilling and remarks _____

RECORD

Cased _____ in. _____ Ft.

Sand _____

Gas _____

Oil _____

Total Depth _____

PRODUCTION

1st 24 hrs. Nat. _____

1st 24 hrs. after shot _____

Gas _____ Cu. Ft.

Dry Hole _____

Abandoned _____

Date

4-2, 1912 Conley Scout _____

Map No. K14 Sec. 1 Twp. 26 R. 4Well No. 1 AbrahamGumpine Company

Contractor

NORTH



SOUTH

Location _____

Rig up ☒

Drilling and Remarks:

*Completed
April 30: 1918
Estimated
at 350 Bbls*

RECORD

Cased _____ in., _____ ft.

Sand 2395-2428

Gas _____

Oil _____

Total Depth _____

PRODUCTION

1st 24 hrs. Nat. _____

1st 24 hrs. after shot _____

Gas _____ Cu. Ft.

Dry Hole _____

Abandoned _____

Date

7/7

191

Scout

Map No. _____ Sec. 1 Twp. 26 R. 4

Well No. 1 Abraham Farm _____

_____ Emp. Company

NORTH

WEST EAST

NEW LOCATION

0

SOUTH

Location _____

Rig up ✓

Drilling and remarks:

RECORD

Cased _____ in. _____ Ft.

Sand _____

Gas _____

Oil _____

Total Depth _____

PRODUCTION

1st 24 hrs. Nat. _____

1st 24 hrs. after shot _____

Gas _____ Cu. Ft.

Dry Hole _____

Abandoned _____

Date

JUN 22 1917

_____, 191____, _____ Scout

Map No. _____ Sec. 1 Twp. 26 R. 4Well No. 1-Union Farm __________ Empire Company

NORTH

WEST

EAST

SOUTH

Location _____

Rig Up _____

Drilling Remarks:

Drilling Remarks:

RECORD

Cased _____ in. _____ ft.

Sand _____

Gas _____

Oil _____

Total Depth _____

PRODUCTION

1st 24 hrs. Nat. _____

1st 24 hrs. after shot _____

Gas _____ cu. ft

Dry Hole _____

Abandoned _____

Map No. K14 Sec. 1 Twp. 26 R. 4
 Well No. 1 Abraham
Engine Company

NORTH

WEST

EAST

SOUTH

Location _____

Rig up ☒ _____

Drilling and Remarks:

FIRST REPORT**RECORD**

Cased _____ in., _____ ft.

Sand _____

Gas _____

Oil _____

Total Depth _____

PRODUCTION

1st 24 hrs. Nat. _____

1st 24 hrs. after shot _____

Gas _____ Cu. Ft.

Dry Hole _____

Abandoned _____


Date

10/31 1917 7 Caidy Scout

Map No. _____ Sec. 1 Twp. 26 R. 4Well No. 194 Farm _____
Empire Company

NORTH

WEST

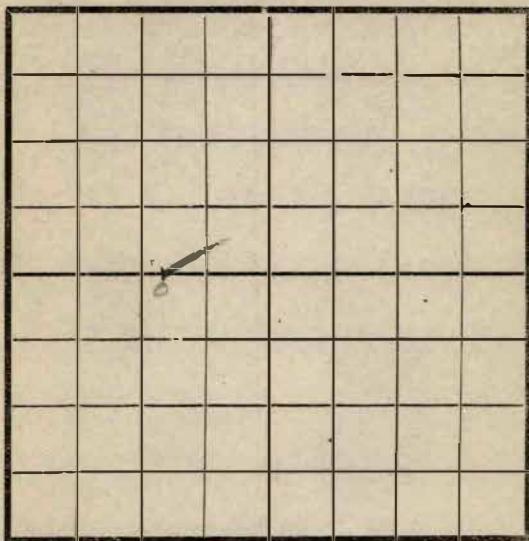

EAST

SOUTH

Location _____

Rig Up _____

Drilling and remarks

250

RECORD

Cased _____ in. _____ Ft.

Sand _____

Gas _____

Oil _____

Total Depth _____

PRODUCTION

1st 24 hrs. Nat. _____

1st 24 hrs. after shot _____

Gas _____ Cu. Ft.

Dry Hole _____

Abandoned _____


Date

11/28, 1917 Conley Scout

Map No. _____ Sec. 1 Twp. 26 R. 4Well No. 1 Abraham Farm _____
Empire Company

NORTH

WEST

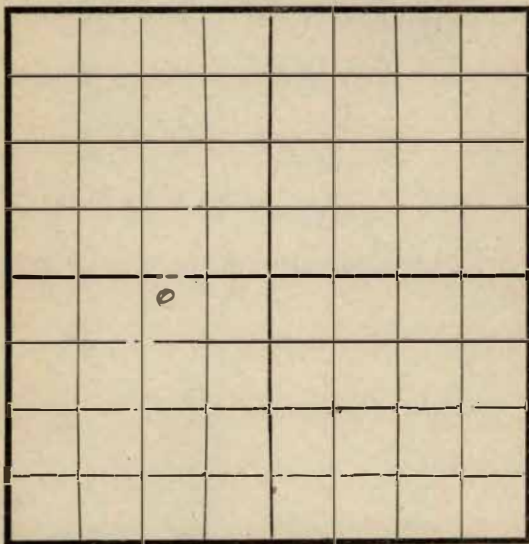

EAST

SOUTH

Location _____

Rig Up _____

Drilling and remarks

500

RECORD

Cased _____ in. _____ Ft.

Sand _____

Gas _____

Oil _____

Total Depth _____

PRODUCTION

1st 24 hrs. Nat. _____

1st 24 hrs. after shot _____

Gas _____ Cu. Ft.

Dry Hole _____


Abandoned _____

Date

12/5, 1917 Candy Scout

Map No. _____ Sec. 1 Twp. 26 R. 4Well No. 1 Abraham Farm _____
E. Murphy Company

NORTH

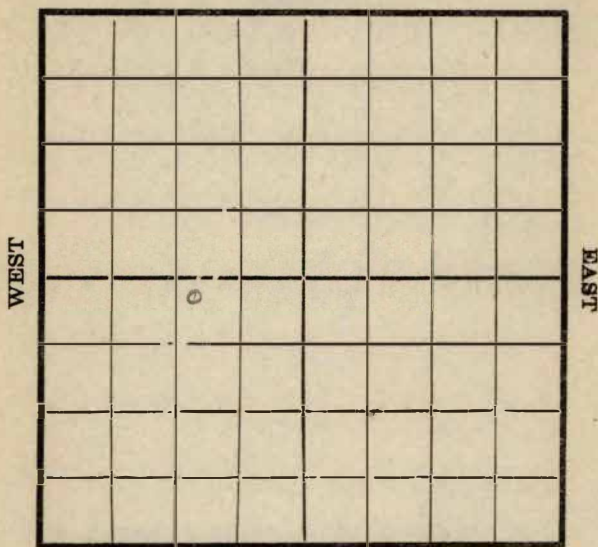

SOUTH

Location _____

Rig Up _____

Drilling and remarks

22750

RECORD

Cased _____ in. _____ Ft.

Sand _____

Gas _____

Oil _____

Total Depth _____

PRODUCTION

1st 24 hrs. Nat. _____

1st 24 hrs. after shot _____

Gas _____ Cu. Ft.

Dry Hole _____

Abandoned _____

Date


1/2, 1918 Cord Scout

Map No. _____ Sec. 1 Twp. 26 R. 4Well No. 1 Albion Farm
Cummins Company

NORTH

WEST

EAST

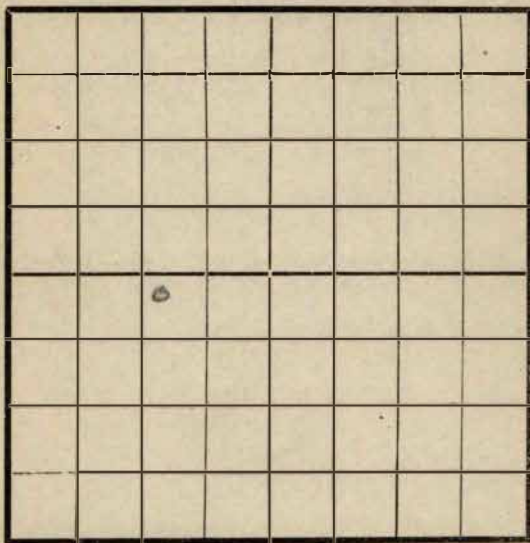

SOUTH

Location _____

Rig Up _____

Drilling and remarks

RECORD

Cased _____ in _____ Ft.

Sand _____

Gas _____

Oil _____

Total Depth _____

PRODUCTION

1st 24 hrs. Nat. _____

1st 24 hrs. after shot _____

Gas _____ Cu. Ft.

Dry Hole _____

Abandoned _____


Date

1/16, 1918 Cummins Scout

Map No. _____ Sec. 1 Twp. 26 R. 4
 Well No. 1010 Farm _____
Engine 283 Company _____

NORTH

WEST

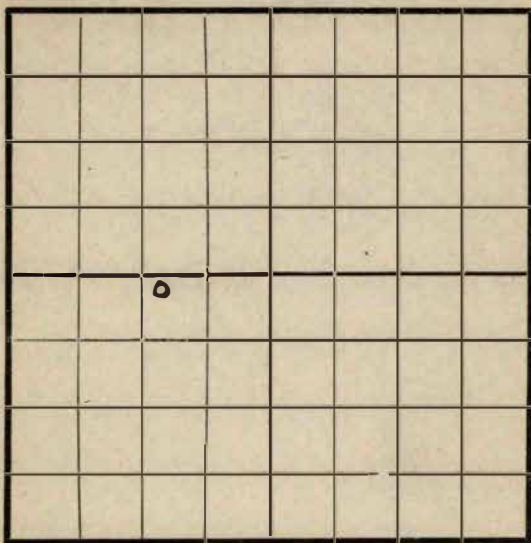

EAST

SOUTH

Location _____
 Rig Up _____
 Drilling and remarks

1010

RECORD

Cased _____ in _____ Ft.
 Sand _____
 Gas _____
 Oil _____
 Total Depth _____

PRODUCTION


1st 24 hrs. Nat. _____
 1st 24 hrs. after shot _____
 Gas _____ Cu. Ft.
 Dry Hole _____
 Abandoned _____

Date

1/23, 1918 Eng. 283 Scout _____

Map No. _____ Sec. 1 Twp. 26 R. 4
 Well No. 1 Abraham Farm _____
Company Company _____

NORTH

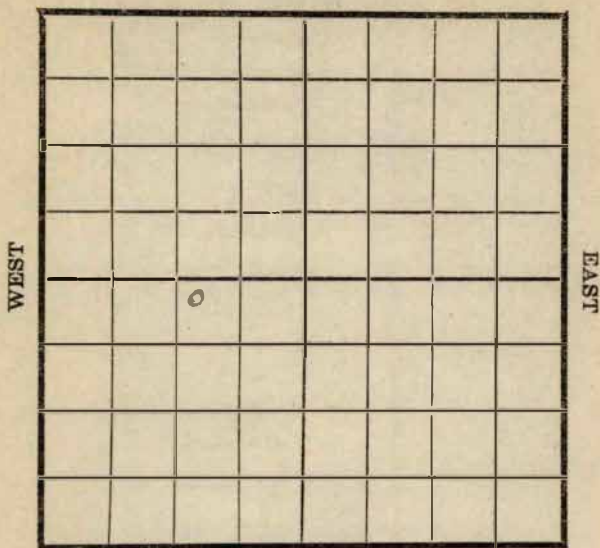

SOUTH

Location _____
 Rig Up _____
 Drilling and remarks

1110'

RECORD

Cased _____ in. _____ Ft.
 Sand _____
 Gas _____
 Oil _____
 Total Depth _____

PRODUCTION

1st 24 hrs. Nat. _____
 1st 24 hrs. after shot _____
 Gas _____ Cu. Ft.
 Dry Hole _____
 Abandoned _____

Date


1/30, 1918 C. E. J. Scout

Scout

Map No. _____ Sec. 1 Twp. 26 R. 4Well No. 10123456789 Farm __________Engineer Company

NORTH

WEST

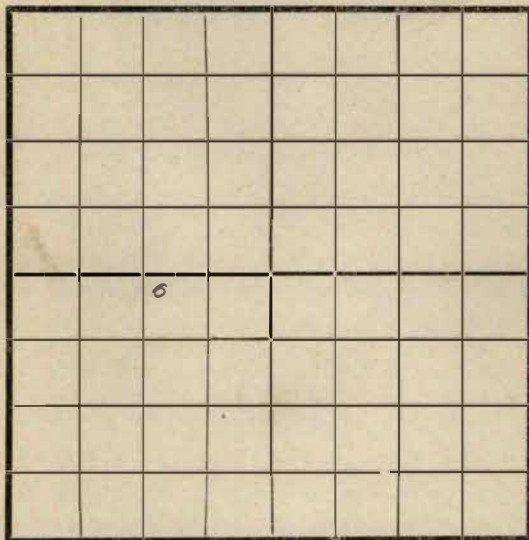

EAST

SOUTH

Location _____

Rig Up _____

Drilling and remarks

1350

RECORD

Cased _____ in _____ Ft.

Sand _____

Gas _____

Oil _____

Total Depth _____

PRODUCTION

1st 24 hrs. Nat. _____

1st 24 hrs. after shot _____

Gas _____ Cu. Ft.

Dry Hole _____

Abandoned _____


Date

2/13, 1918 Cond Scout

Map No. _____ Sec. 1 Twp. 26 R. 4
 Well No. 1 Abraham Farm _____
Engine Company _____

NORTH

WEST

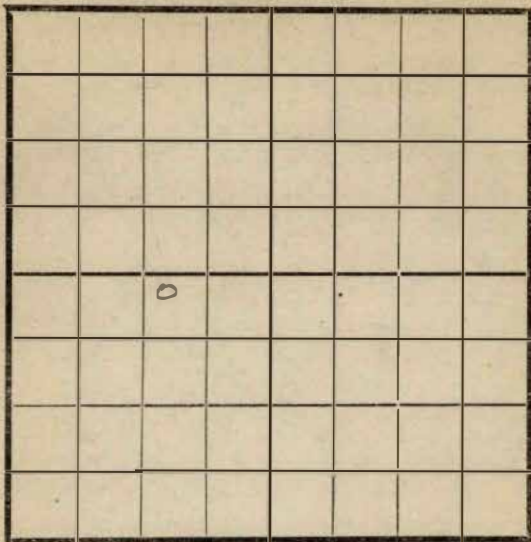

EAST

SOUTH

Location _____
 Rig Up _____
 Drilling and remarks

1575

RECORD

Cased _____ in. _____ Ft.
 Sand _____
 Gas _____
 Oil _____
 Total Depth _____

PRODUCTION

1st 24 hrs. Nat. _____
 1st 24 hrs. after shot _____
 Gas _____ Cu. Ft.
 Dry Hole _____
 Abandoned _____

Date

720, 1918 Cooney Scout _____

Map No. _____ Sec. _____ Twp. 26 R. 4


Well No. 124 Farm _____

_____ Company _____

NORTH

WEST

EAST

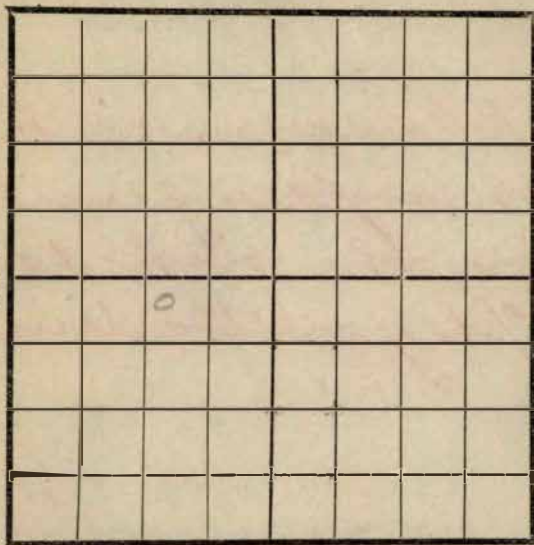

SOUTH

Location _____

Rig Up _____

Drilling and remarks

1610

RECORD

Cased _____ in _____ Ft.

Sand _____

Gas _____

Oil _____

Total Depth _____

PRODUCTION

1st 24 hrs. Nat. _____

1st 24 hrs. after shot _____

Gas _____ Cu. Ft.

Dry Hole _____


Abandoned _____

Date

2/27, 1918 S. C. C. C. Scout

Well No. _____
Map No. _____
Twp. _____
Range _____
County _____

NORTH

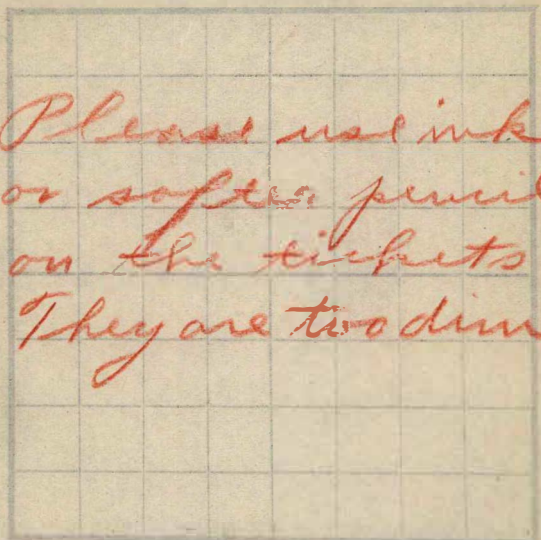

*Please use ink
or soft pencil
on the tickets
They are too dim.*

SOUTH

RECORD		Location	Remarks
Feet	in		
		Sand	
		Gas	
		Oil	
Total Depth			


PRODUCTION		Gas	Oil	Remarks
1st 24 hrs.	Net			
1st 24 hrs.	after shot			
Gas	ft.			
Oil	ft.			
Abandoned				

Map No. _____ Sec. 1 Twp. 26 R. 4

Well No. 100 Farm _____
Engine Company

NORTH

WEST

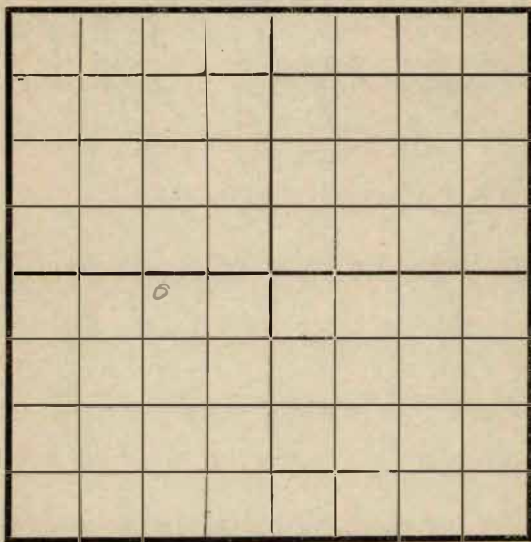

EAST

SOUTH

Location _____

Rig Up _____

Drilling and remarks

1620

RECORD

Cased _____ in. _____ Ft.

Sand _____

Gas _____

Oil _____

Total Depth _____

PRODUCTION

1st 24 hrs. Nat. _____

1st 24 hrs. after shot _____

Gas _____ Cu. Ft.

Dry Hole _____

Abandoned _____

Date

3/6, 1918 Candiff


Scout

Map No. _____ Sec. 1 Twp. 26 R. 4

Well No. 1000 Farm _____
Company Company _____

NORTH

WEST

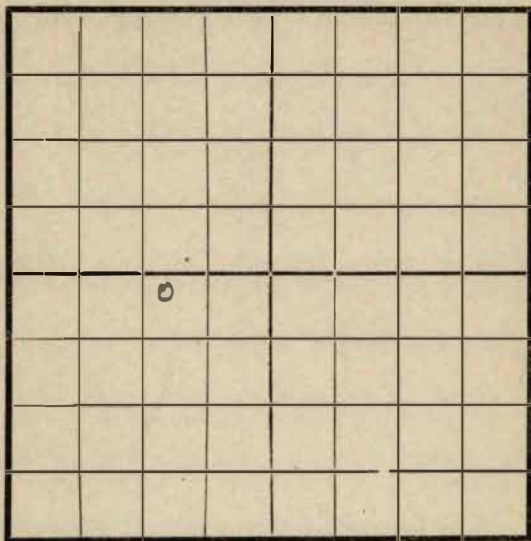

EAST

SOUTH

Location _____

Rig Up _____

Drilling and remarks

1775

RECORD

Cased _____ in. _____ Ft.

Sand _____

Gas _____

Oil _____

Total Depth _____

PRODUCTION

1st 24 hrs. Nat. _____

1st 24 hrs. after shot _____

Gas _____ Cu. Ft.

Dry Hole _____


Abandoned _____

Date

3/13, 1918 S. Condy Scout _____

Map No. _____ Sec. 1 Twp. 26 R. 4
 Well No. 1 Abraham Farm _____
Empire Company

NORTH

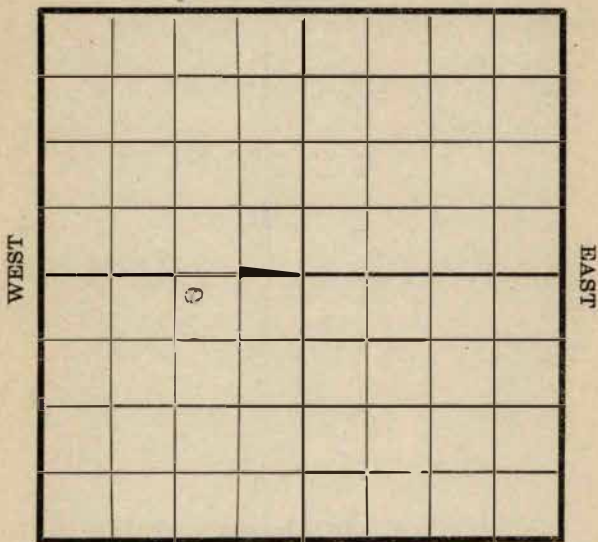

SOUTH

Location _____
 Rig Up _____
 Drilling and remarks

1900

RECORD

Cased _____ in. _____ Ft.
 Sand _____
 Gas _____
 Oil _____
 Total Depth _____

PRODUCTION

1st 24 hrs. Nat. _____
 1st 24 hrs. after shot _____
 Gas _____ Cu. Ft.
 Dry Hole _____
 Abandoned _____

Date


3/21, 1911 S. Cardy Scout

Map No. _____ Sec. 1 Twp. 26 R. 2Well No. 1 Abraham
Empire Company

NORTH

WEST

EAST

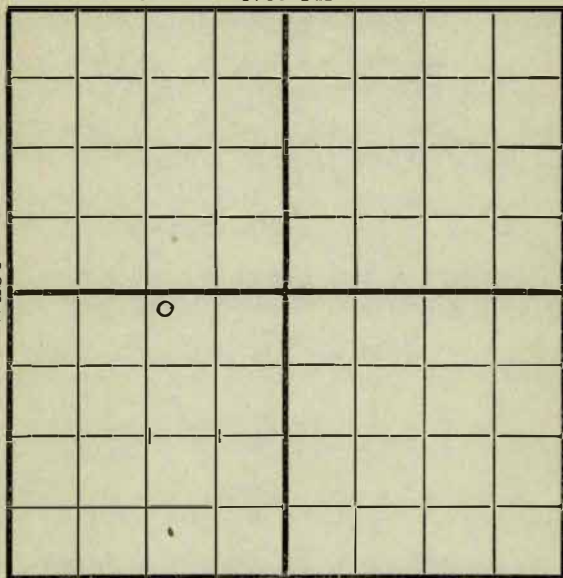

SOUTH

Location _____

Rig up _____

Drilling and Remarks:

2395**RECORD**

Cased _____ in., _____ ft.

Sand _____

Gas _____

Oil _____

Total Depth _____

PRODUCTION

1st 24 hrs. Nat. _____

1st 24 hrs. after shot _____

Gas _____ Cu. Ft.

Dry Hole _____

Abandoned _____

Date

APR 3 1918

191


Scout

Condy

Map No. _____ Sec. 1 Twp. 26 R. 4
 Well No. 1 Abraham Farm _____
Company Company _____

NORTH

WEST

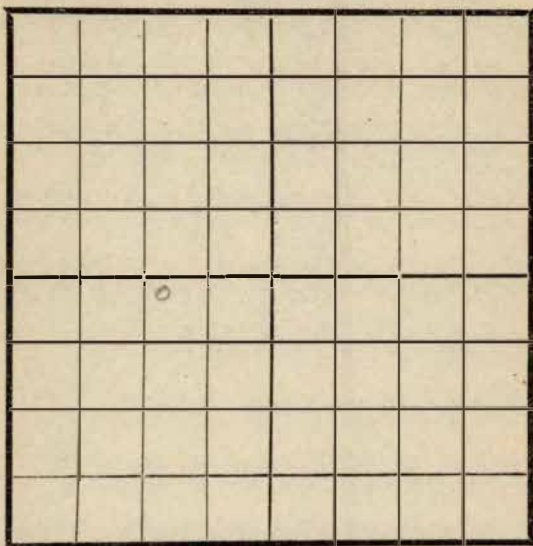

EAST

SOUTH

Location _____
 Rig Up _____
 Drilling and remarks _____

SD 2395

RECORD

Cased _____ in. _____ Ft.
 Sand _____
 Gas _____
 Oil _____
 Total Depth _____

PRODUCTION

1st 24 hrs. Nat. _____
 1st 24 hrs. after shot _____
 Gas _____ Cu. Ft.
 Dry Hole _____
 Abandoned _____


Date

4/10, 1918 C. Condy Scout _____

Map No. _____ Sec. 1 Twp. 26 R. 4
 Well No. 1 Abraham Farm _____
Engine Company _____

NORTH

WEST

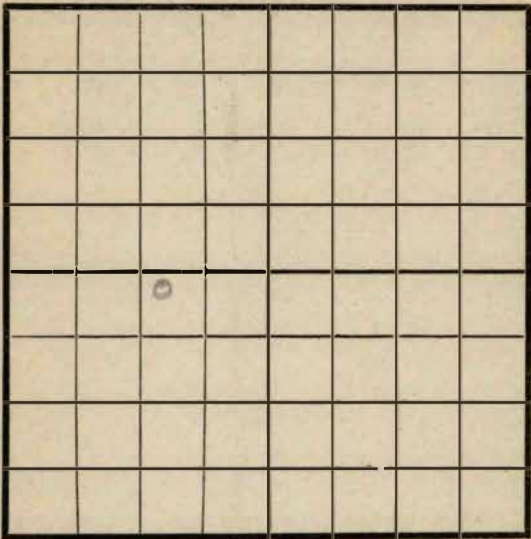

EAST

SOUTH

Location _____
 Rig Up _____
 Drilling and remarks

RECORD

Cased _____ in. _____ Ft.
 Sand _____
 Gas _____
 Oil _____
 Total Depth _____

PRODUCTION

1st 24 hrs. Nat. _____
 1st 24 hrs. after shot _____
 Gas _____ Cu. Ft.
 Dry Hole _____
 Abandoned _____

Date

3/27, 1918 E. E. Canby Scout


Map No. _____ Sec. 1 Twp. 26 R. 4

Well No. 1 Abraham Farm

Empire Company

NORTH

WEST

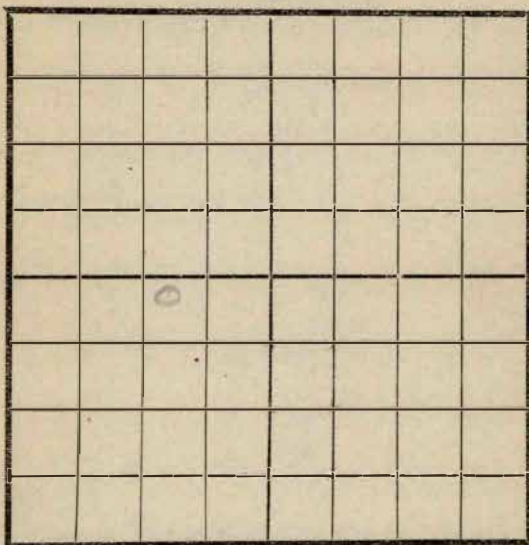

EAST

SOUTH

Location _____

Rig Up _____

Drilling and remarks

SD 2395

RECORD

Cased _____ in. _____ Ft.

Sand _____

Gas _____

Oil _____

Total Depth _____

PRODUCTION

1st 24 hrs. Nat. _____

1st 24 hrs. after shot _____

Gas _____ Cu. Ft.

Dry Hole _____

Abandoned _____

Date

4/17, 1918 J. Condy Scout

Map No. K14 Sec. 1 Twp. 26 R. 4Well No. 1. Ahroshum FarmEmpire Company

NORTH

WEST

EAST

COMPLETED

SOUTH

Location -----

Rig Up -----

Drilling and remarks

Set at
350 Bbls

RECORD

Cased ----- in. ----- Ft.

Sand 2195-2428

Gas -----

Oil -----

Total Depth -----

PRODUCTION

1st 24 hrs. Nat. -----

1st 24 hrs. after shot -----

Gas ----- Cu. Ft.

Dry Hole -----

Abandoned -----

Date

4/25, 1918 8 Comd. Scout

Map No. K4 Sec. 1 Twp. 26 R. 4Well No. Plat Farm

Company

NORTH

WEST

EAST

SOUTH

Location -----

Rig Up -----

Drilling Remarks:

Drilling Remarks:

RECORD

Cased ----- in. ----- ft.

Sand -----

Gas -----

Oil -----

Total Depth -----

PRODUCTION

1st 24 hrs. Nat. -----

1st 24 hrs. after shot -----

Gas ----- cu. ft

Dry Hole -----


Abandoned -----

Map No. _____ Sec. 1 Twp. 26 R. 4

Well No. _____ Farm _____

Company _____

NORTH

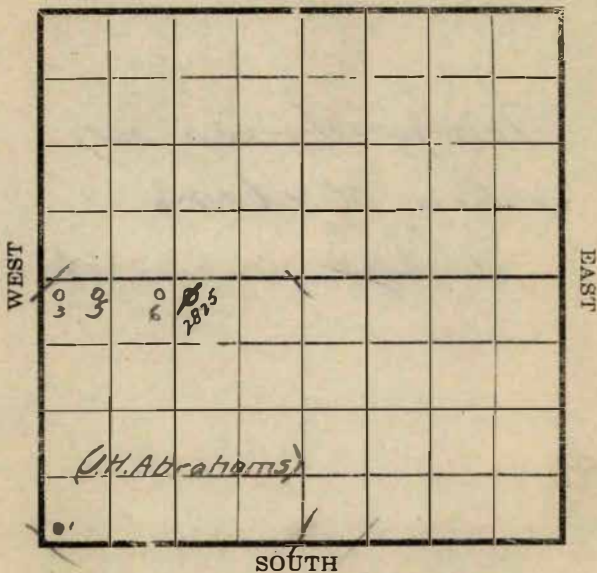

Location _____

Rig Up _____

Drilling and remarks _____

RECORD

Cased _____ in. _____ Ft.

Sand _____

Gas _____

Oil _____

Total Depth _____

PRODUCTION

1st 24 hrs. Nat. _____

1st 24 hrs. after shot _____

Gas _____ Cu. Ft.

Dry Hole _____

Abandoned _____

Date _____

_____, 191____ Scout _____

Map as
this ticket?
What is correct?

RECORD

REPRODUCTION

STATE Kansas

Form 605—Order by No.
Burkhart Printing & Stationery Co., Tulsa.

COUNTY Butler

SECTION One TOWNSHIP 26

RANGE 4

03. 05. 06. 01. 02. 03.	01. 02. 03.		
ROLSTON	ABRAHAM		
04. 07. 08.	04. 05. 06.		
(Empire)	(Empire)		

REMARKS: Some question whether this dry hole was drilled to this depth.