


Map No. _____ Sec. 1 Twp. 26 R. 4
 Well No. 3 Abraham Farm _____
Empire Company _____
 NORTH

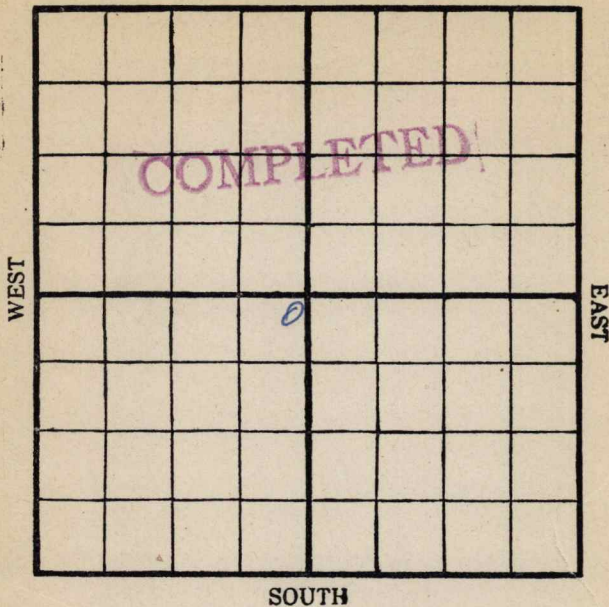

Location _____

Rig Up _____

Drilling Remarks:

Drilling Remarks:

RECORD

Cased _____ in. _____ ft.
 Sand _____
 Gas _____
 Oil _____
 Total Depth _____


PRODUCTION

1st 24 hrs. Nat. _____
 1st 24 hrs. after shot _____
 Gas _____ cu. ft
 Dry Hole _____
 Abandoned _____

Map No. _____ Sec. 1 Twp. 26 R. 4Well No. 3 Abraham Farm _____
Company Company _____

NORTH

WEST

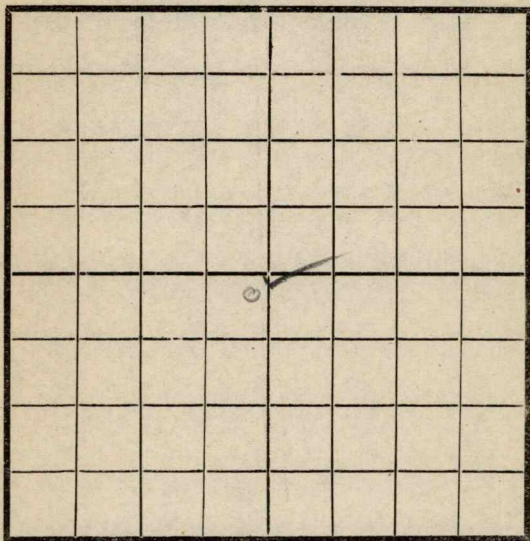

EAST

SOUTH

Location _____

Rig Up ☒ _____

Drilling and remarks _____

RECORD

Cased _____ in. _____ Ft.

Sand _____

Gas _____

Oil _____

Total Depth _____

PRODUCTION

1st 24 hrs. Nat. _____

1st 24 hrs. after shot _____

Gas _____ Cu. Ft.

Dry Hole _____

Abandoned _____


Date

11/28, 1917 Condy Scout

Map No. _____ Sec. 1 Twp. 36 R. 4Well No. 3 Abraham Farm
Engine Company

NORTH

WEST

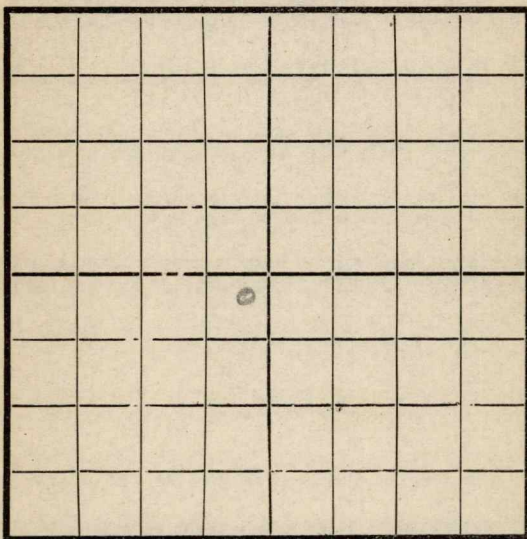

EAST

SOUTH

Location ✓Rig Up ✓

Drilling and remarks

RECORD

Cased _____ in. _____ Ft.

Sand _____

Gas _____

Oil _____

Total Depth _____

PRODUCTION

1st 24 hrs. Nat. _____

1st 24 hrs. after shot _____

Gas _____ Cu. Ft.

Dry Hole _____

Abandoned _____


Date

12/5-7, 1917 Conroy Scout

Map No. _____ Sec. 1 Twp. 26 R. 4Well No. 3 Abraham Farm
Engine Company

NORTH

WEST

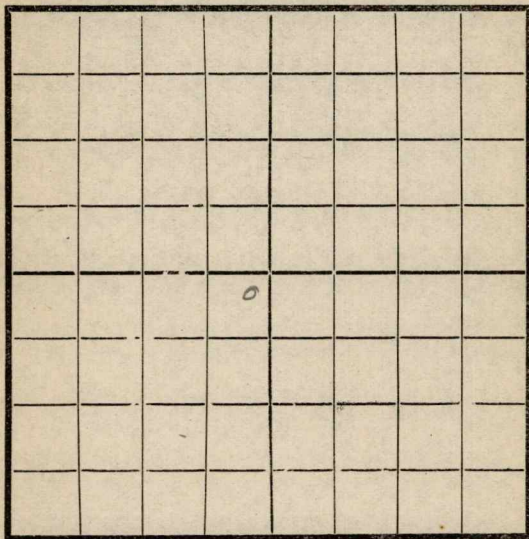

EAST

SOUTH

Location _____

Rig Up ☒ _____

Drilling and remarks _____

RECORD

Cased _____ in. _____ Ft.

Sand _____

Gas _____

Oil _____

Total Depth _____

PRODUCTION

1st 24 hrs. Nat. _____

1st 24 hrs. after shot _____

Gas _____ Cu. Ft.

Dry Hole _____

Abandoned _____


Date

1/2, 1918 Condy Scout

Map No. _____ Sec. 1 Twp. 26 R. 4
 Well No. 3 @ Indian Farm _____
Company Company _____

NORTH

WEST

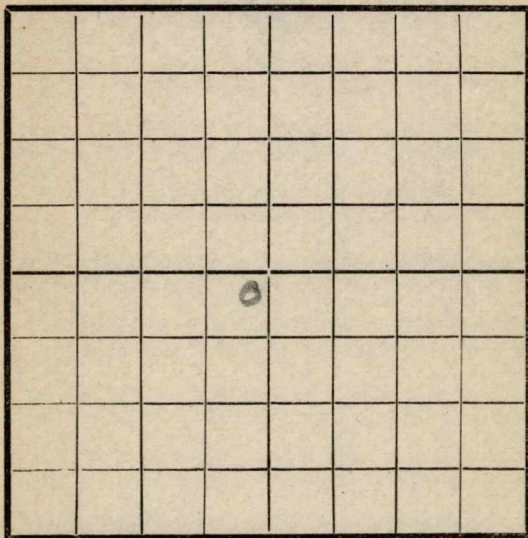

EAST

SOUTH

Location _____
 Rig Up ☒ _____
 Drilling and remarks _____

RECORD

Cased _____ in. _____ Ft.
 Sand _____
 Gas _____
 Oil _____
 Total Depth _____

PRODUCTION

1st 24 hrs. Nat. _____
 1st 24 hrs. after shot _____
 Gas _____ Cu. Ft.
 Dry Hole _____
 Abandoned _____

Date

1/16, 1918 S. Conley Scout

Map No. _____ Sec. 1 Twp. 26 R. 4Well No. 3 Abraham Farm _____Company Cummins

NORTH

WEST

EAST

SOUTH

Location _____

Rig Up _____

Drilling and remarks

Rigging up
 Hartless
 Oil Co
 E. L. Dorado

RECORD

Cased _____ in _____ Ft

Sand _____

Gas _____

Oil _____

Total Depth _____

PRODUCTION

1st 24 hrs. Nat. _____

1st 24 hrs. after shot _____

Gas _____ Cu. Ft

Dry Hole _____

Abandoned _____

Date


Nov 8, 1911 _____

Scout _____

Map No. _____ Sec. 1 Twp. 26 R. 4
 Well No. 3 Abraham Farm _____
Engine Company _____

NORTH

WEST

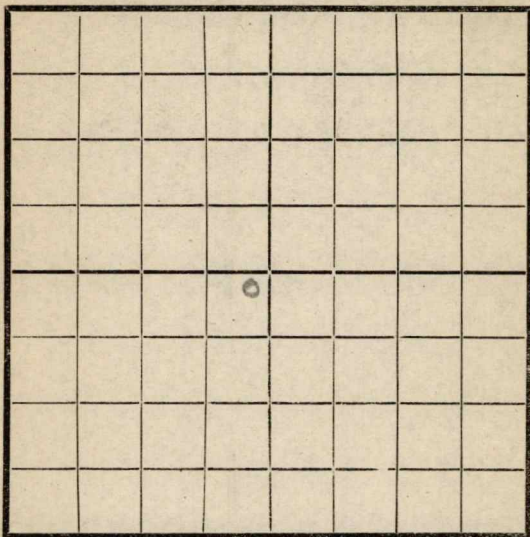

EAST

SOUTH

Location _____
 Rig Up _____
 Drilling and remarks

300

RECORD

Cased _____ in. _____ Ft.
 Sand _____
 Gas _____
 Oil _____
 Total Depth _____

PRODUCTION

1st 24 hrs. Nat. _____
 1st 24 hrs. after shot _____
 Gas _____ Cu. Ft.
 Dry Hole _____
 Abandoned _____


Date

3/20, 1918 C. C. C. Scout

Map No. _____ Sec. _____ Twp. 26 R. 4Well No. 3 Abraham Farm
Campine Company

NORTH

WEST

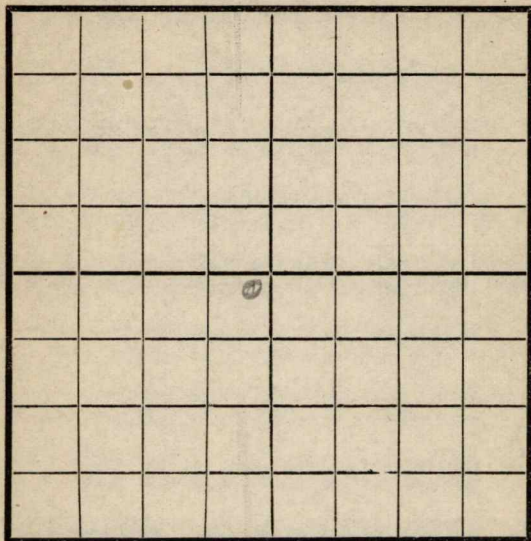

EAST

SOUTH

Location _____

Rig Up _____

Drilling and remarks

950

RECORD

Cased _____ in. _____ Ft.

Sand _____

Gas _____

Oil _____

Total Depth _____

PRODUCTION

1st 24 hrs. Nat. _____

1st 24 hrs. after shot _____

Gas _____ Cu. Ft.

Dry Hole _____

Abandoned _____


Date

3/27, 1918 Campine Scout

Map No. _____ Sec. 1 Twp. 26 R. 4
 Well No. 3 Abrams
Empire Company

NORTH

WEST

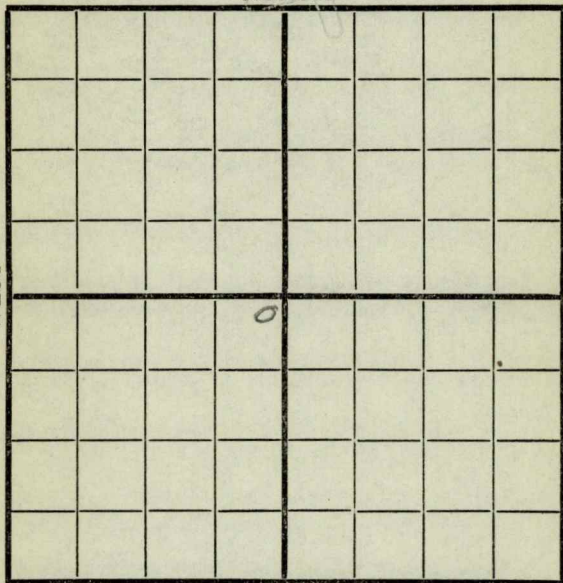

EAST

SOUTH

RECORD

Location _____

Cased _____ in., _____ ft.

Rig up _____

Sand _____

Drilling and Remarks:

Gas _____

Oil _____

Total Depth _____

1400

PRODUCTION

1st 24 hrs. Nat. _____

1st 24 hrs. after shot _____

Gas _____ Cu. Ft.

Dry Hole _____

Abandoned _____

Date

APR 3 1918

Candy

Scout


Map No. _____ Sec. 1 Twp. 26 R. 4

Well No. 3 Abrahams Farm _____

Empire Company _____

NORTH

WEST

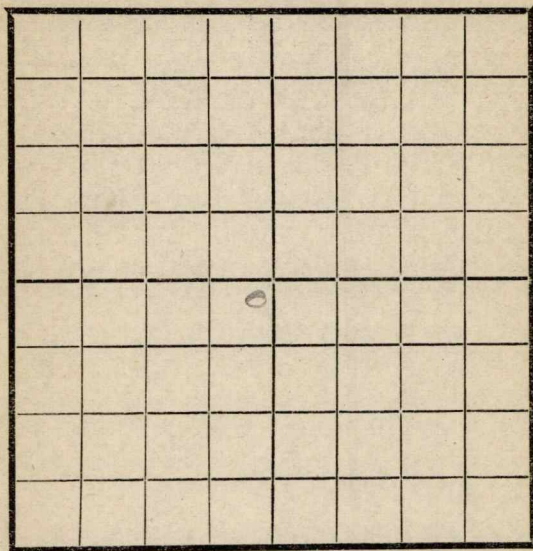

EAST

SOUTH

Location _____

Rig Up _____

Drilling and remarks

1510

RECORD

Cased _____ in. _____ Ft.

Sand _____

Gas _____

Oil _____

Total Depth _____

PRODUCTION

1st 24 hrs. Nat. _____

1st 24 hrs. after shot _____

Gas _____ Cu. Ft.

Dry Hole _____

Abandoned _____

Date

4/10, 1918 S. Cordry

Scout _____

ap No. _____ Sec. 1 Twp. 26 R. 4
 ell No. 3 Abraham Farm
Company Company

NORTH

WEST

EAST

SOUTH

ocation _____
 g Up _____
 illing and remarks

1790

RECORD

Cased _____ in. _____ Ft.
 Sand _____
 Gas _____
 Oil _____
 Total Depth _____

PRODUCTION

1st 24 hrs. Nat. _____
 1st 24 hrs. after shot _____
 Gas _____ Cu. Ft.
 Dry Hole _____
 Abandoned _____

te

4/17/1918 Company


191

Scout

Map No. _____ Sec. 1 Twp. 26 R. 4
 Well No. 3 Abraham Farm _____
Engine Company _____

NORTH

WEST

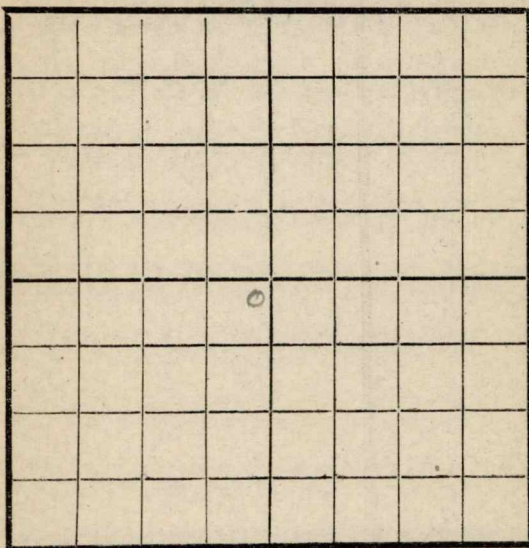

EAST

SOUTH

RECORD

Location _____

Cased _____ in. _____ Ft.

Rig Up _____

Sand _____

Drilling and remarks

Gas _____

Oil _____

Total Depth _____

2235

PRODUCTION

1st 24 hrs. Nat. _____

1st 24 hrs. after shot _____

Gas _____ Cu. Ft.

Dry Hole _____

Abandoned _____


Date

4/24, 1918 S. Condit Scout

Map No. K14 Sec. 1 Twp. 26 R. 4
 Well No. 3 Abraham Farm
Engine Company

NORTH

WEST

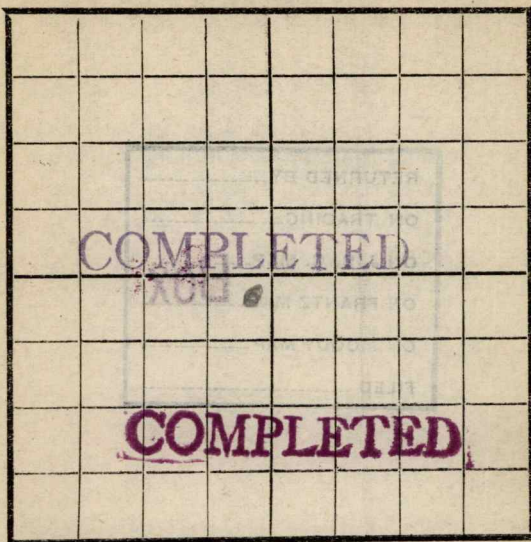

EAST

SOUTH

Location -----

Rig Up -----

Drilling and remarks

Est at

500

Bble

RECORD

Cased ----- in ----- Ft.

Sand 2380-2409

Gas -----

Oil -----

Total Depth -----

PRODUCTION

1st 24 hrs. Nat. -----

1st 24 hrs. after shot -----

Gas ----- Cu. Ft.

Dry Hole -----

Abandoned -----

Date

5/1, 1918 8 Conley Scout