


Map No. _____ Sec. 1 Twp. 26 R. 4
 Well No. 4 Jowler Farm
Empire Gas Co. Company

NORTH

WEST

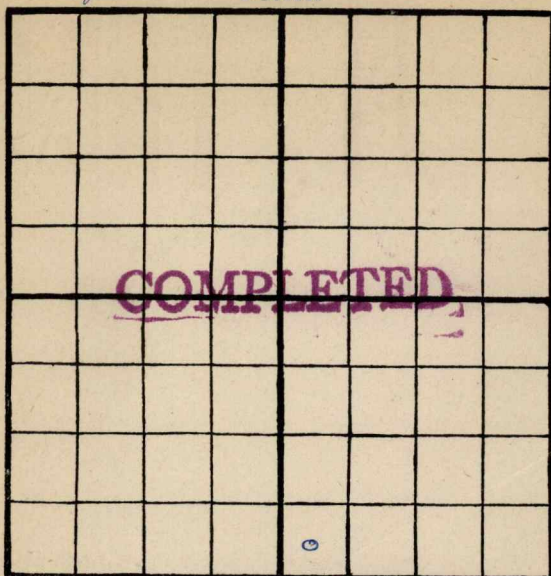

EAST

SOUTH

Location _____

Rig Up _____

Drilling Remarks:

Drilling Remarks:

RECORD

Cased _____ in. _____ ft.

Sand _____

Gas _____

Oil _____

Total Depth _____

PRODUCTION

1st 24 hrs. Nat. _____

1st 24 hrs. after shot _____

Gas _____ cu. ft.


Dry Hole _____

Abandoned _____

Map No. _____ Sec. 1 Twp. 26 R. 4
 Well No. 477 Farm _____
Engine Company

NORTH

WEST

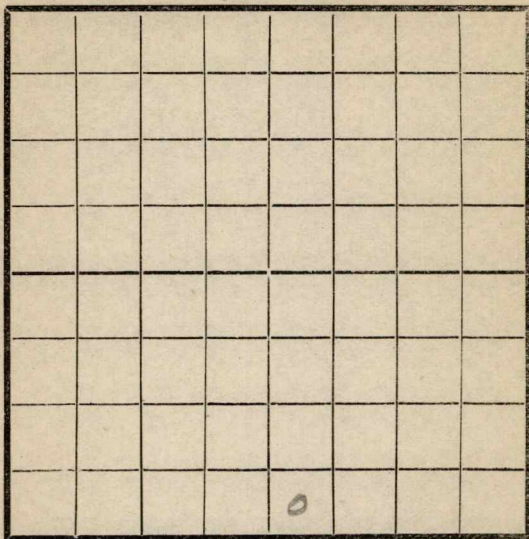

EAST

SOUTH

Location _____

Rig Up ☒ _____

Drilling and remarks _____

RECORD

Cased _____ in _____ Ft.

Sand _____

Gas _____

Oil _____

Total Depth _____

PRODUCTION

1st 24 hrs. Nat. _____

1st 24 hrs. after shot _____

Gas _____ Cu. Ft.

Dry Hole _____

Abandoned _____

Date _____

_____, 191____ Scout _____

Map No. _____ Sec. 1 Twp. 26 R. 4

Well No. 4 Fowler

Company

Contractor

NORTH

WEST

EAST

SOUTH

Location _____

Rig up. ✓

Drilling and Remarks:

RECORD

Cased _____ in., _____ ft.

Sand _____

Gas _____

Oil _____

Total Depth.....

PRODUCTION

1st 24 hrs. Nat. -----

1st 24 hrs. after shot.....

Gas.....Cu. Ft.

Dry Hole.....

Abandoned.....

Date _____

6/26 191. J. C. Scout

Map No. _____ Sec. 1 Twp. 26 R. 4Well No. 4 Fowler


_____ Company

_____ Contractor

NORTH

WEST

EAST

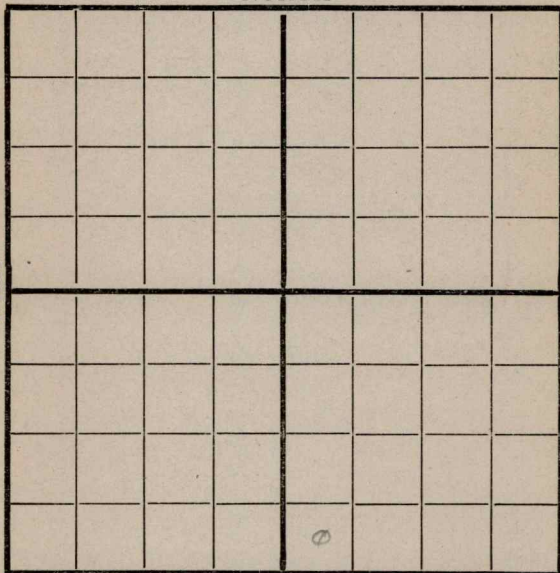

SOUTH

Location _____

Rig up _____

Drilling and Remarks:

800

RECORD

Cased _____ in., _____ ft.

Sand _____

Gas _____

Oil _____

Total Depth _____

PRODUCTION

1st 24 hrs. Nat. _____

1st 24 hrs. after shot _____

Gas _____ Cu. Ft.

Dry Hole _____

Abandoned _____

Date

7/10

191

S. Condit

Scout

Map No. _____ Sec. 1 Twp. 26 R. 4Well No. 4 Fowles

_____ Company

_____ Contractor

NORTH

WEST

EAST

SOUTH

Location _____

Rig up _____

Drilling and Remarks:

1100

RECORD

Cased _____ in., _____ ft.

Sand _____

Gas _____

Oil _____

Total Depth _____

PRODUCTION

1st 24 hrs. Nat. _____

1st 24 hrs. after shot _____

Gas _____ Cu. Ft.

Dry Hole _____

Abandoned _____

Date

2/17

191

J. Carley

Scout

Map No. _____ Sec. 1 Twp. 26 R. 4Well No. 4 Fowler


_____ Company

_____ Contractor

NORTH

WEST

EAST

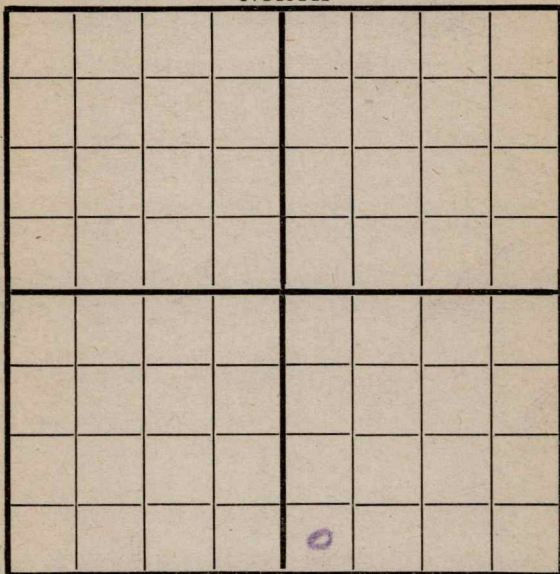

SOUTH

Location _____

Rig up _____

Drilling and Remarks:

1600

RECORD

Cased _____ in., _____ ft.

Sand _____

Gas _____

Oil _____

Total Depth _____

PRODUCTION

1st 24 hrs. Nat. _____

1st 24 hrs. after shot _____

Gas _____ Cu. Ft.

Dry Hole _____

Abandoned _____

Date


7/24 1918 8 Cardiff Scout

Map No. _____ Sec. 1 Twp. 26 R. 4Well No. 4 Fowler
Empire Company
Contractor _____

NORTH

WEST

EAST

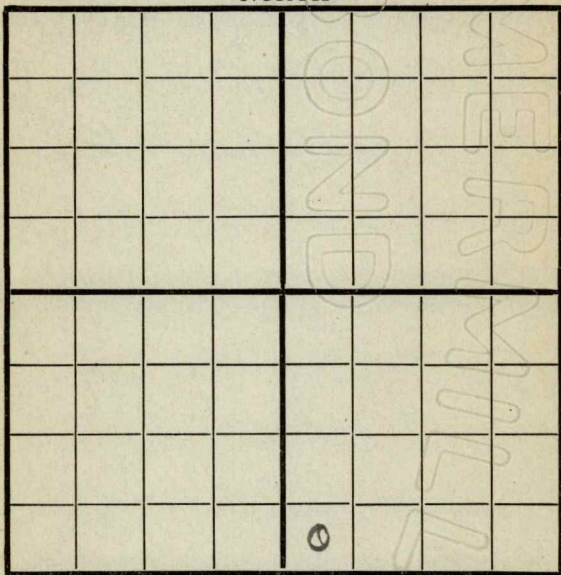

SOUTH

330 ~~1/2~~ S. x 330 ~~1/2~~ W. L.

RECORD

Location _____

Cased _____ in., _____ ft.

Rig up _____

Sand _____

Drilling and Remarks:

Gas _____

Oil _____

Total Depth _____

PRODUCTION

1st 24 hrs. Nat. _____

1st 24 hrs. after shot _____

Gas _____ Cu. Ft.


Dry Hole _____

Abandoned _____

Date

7/31 1918 J. C. Conley Scout

Map No. _____ Sec. 1 Twp. 26 R. 4
Well No. 4 Fowler
Engine _____ Company _____
Contractor _____

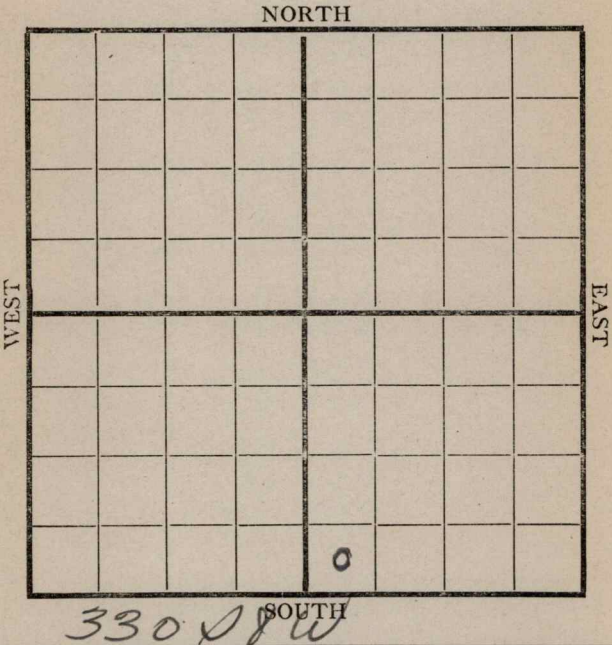

Location _____ Rig up _____ Drilling and Remarks: <u>Shut down</u> <u>1600</u>	RECORD Cased _____ in., _____ ft. Sand _____ Gas _____ Oil _____ Total Depth _____
	PRODUCTION 1st 24 hrs. Nat. _____ 1st 24 hrs. after shot _____ Gas _____ Cu. Ft. Dry Hole _____ Abandoned _____

Date 8/7 1911 P. Condy Scout

Map No. _____ Sec. 1 Twp. 26 R. 4

Well No. 4 Fowler


Engine Company

Contractor

NORTH

WEST

EAST

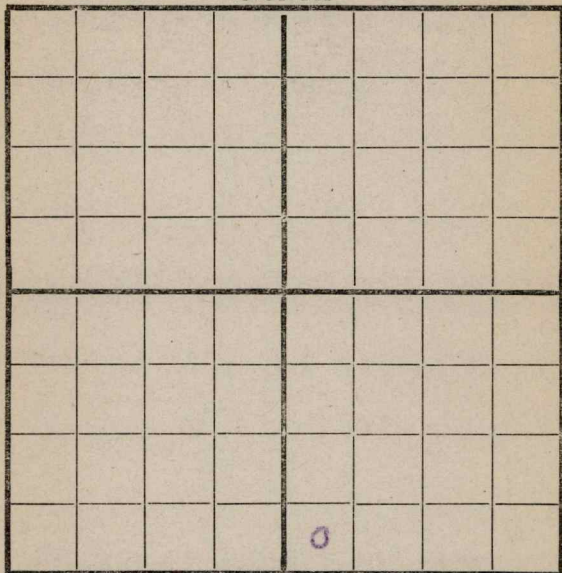

SOUTH

3305
33011

Location _____

Rig up _____

Drilling and Remarks:

RECORD

Cased _____ in., _____ ft.

Sand _____

Gas _____

Oil _____

Total Depth _____

PRODUCTION

1st 24 hrs. Nat. _____

1st 24 hrs. after shot _____

Gas _____ Cu. Ft.

Dry Hole _____

Abandoned _____

Date

8/15 1918 C. G. L. Scout

fishing
@
1400'

Map No. _____ Sec. 1 Twp. 26 R. 4

Well No. 4 Fowler


E. Empires Company

Contractor _____

NORTH

WEST

EAST

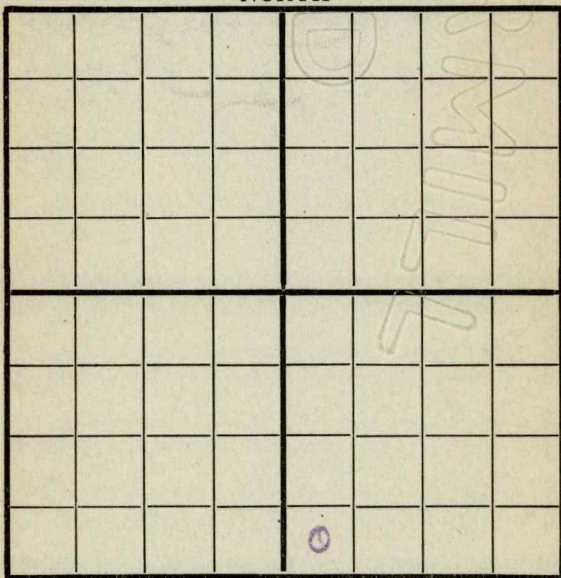

SOUTH

330' ASW

Location _____

Rig up _____

Drilling and Remarks:

1615'

RECORD

Cased _____ in., _____ ft.

Sand _____

Gas _____

Oil _____

Total Depth _____

PRODUCTION

1st 24 hrs. Nat. _____

1st 24 hrs. after shot _____

Gas _____ Cu. Ft.

Dry Hole _____

Abandoned _____

Date

8/22 1918

Pyle

Scout


Map No. 1514 Sec. 1 Twp. 26 R. 4Well No. 4 FowlerEngine Company

Contractor

NORTH

WEST

EAST

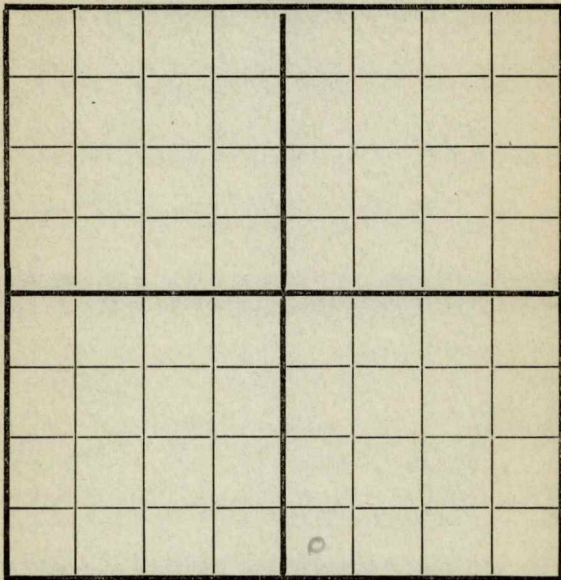

SOUTH

330 S + W

Location _____

Rig up _____

Drilling and Remarks:

2080

RECORD

Cased _____ in., _____ ft.

Sand _____

Gas _____

Oil _____

Total Depth _____

PRODUCTION

1st 24 hrs. Nat. _____

1st 24 hrs. after shot _____

Gas _____ Cu. Ft.

Dry Hole _____

Abandoned _____

Date

8/28

191

P. C. Cady

Scout


Map No. 1414 Sec. 1 Twp. 26 R. 4Well No. 4 FowlerE engine Company _____

Contractor _____

NORTH

WEST

EAST

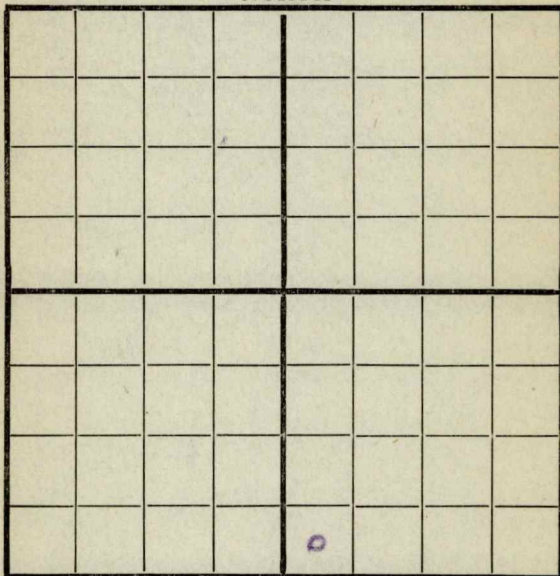

SOUTH

330 S + W

Location _____

Rig up _____

Drilling and Remarks:

2325

RECORD

Cased _____ in., _____ ft.

Sand _____

Gas _____

Oil _____

Total Depth _____

PRODUCTION

1st 24 hrs. Nat. _____

1st 24 hrs. after shot _____

Gas _____ Cu. Ft.

Dry Hole _____

Abandoned _____

Date

9/4 1918 J. Carney Scout _____

Map No. K14 Sec. 1 Twp. 26 R. 4Well No. 4 FowlerCompany Empire

Contractor _____

NORTH

WEST

COMPLETED

EAST

SOUTH

RECORD

Location _____

Cased _____ in., _____ ft.

Rig up _____

Sand 2418-2478

Drilling and Remarks:

Gas _____

Oil _____

Total Depth _____

PRODUCTION

1st 24 hrs. Nat. _____

1st 24 hrs. after shot _____

Gas _____ Cu. Ft.

Dry Hole _____

Abandoned _____

Date

9/11

191

S. C. Candy

Scout