


Map No. _____ Sec. 1 Twp. 26 R. 4
 Well No. 8 Fowler Farm _____
Empire Company _____

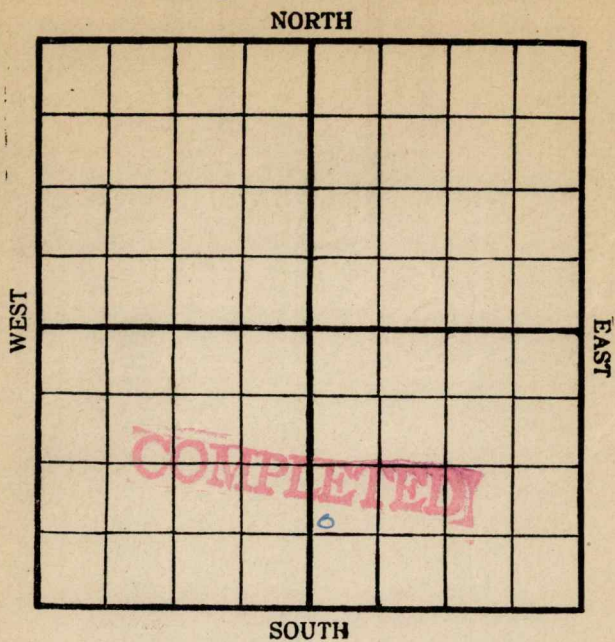

Location _____

Drilling Remarks:

Rig Up _____

Drilling Remarks:

RECORD

Cased _____ in. _____ ft.

Sand _____

Gas _____

Oil _____

Total Depth _____

PRODUCTION

1st 24 hrs. Nat. _____

1st 24 hrs. after shot _____

Gas _____ cu. ft.

Dry Hole _____

Abandoned _____

Map No. K14 Sec. 1 Twp. 26 R. 4

Well No. 8 Fowler

Company

Contractor

NORTH

WEST

EAST

SOUTH

$$700' S - 200 W$$

Location _____

Rig up.....

Drilling and Remarks:

FIRST REPORT

RECORD

Cased _____ in., _____ ft.

Sand_____

Gas -----

Oil_____

Total Depth_____

PRODUCTION

1st 24 hrs. Nat. _____

1st 24 hrs. after shot-----

Gas.....Cu. Ft.

Dry Hole

Abandoned.....

Date _____

9/27 1918. Quincy Scout

Map No. K14 Sec. 1 Twp. 26 R. 4Well No. 830012Company Empire

Contractor _____

NORTH

WEST

EAST

SOUTH

700' S - 200' W

Location _____

Rig up ☒

Drilling and Remarks:

RECORD

Cased _____ in., _____ ft.

Sand _____

Gas _____

Oil _____

Total Depth _____

PRODUCTION

1st 24 hrs. Nat. _____

1st 24 hrs. after shot _____

Gas _____ Cu. Ft.

Dry Hole _____

Abandoned _____

Date

10/3 191 8 Canby Scout

Map No. K14 Sec. 1 Twp. 26 R. 4
 Well No. 8 Fowler
Engine Company
 Contractor

NORTH								
WEST								EAST
SOUTH								

700 S - 300 W

Location _____

Rig up ☒ _____

Drilling and Remarks:

RECORD

Cased _____ in., _____ ft.

Sand _____

Gas _____

Oil _____

Total Depth _____

PRODUCTION

1st 24 hrs. Nat. _____

1st 24 hrs. after shot _____

Gas _____ Cu. Ft.

Dry Hole _____

Abandoned _____

Date

10/9 191 8 C. Conley Scout

Map No. 174 Sec. 1 Twp. 26 R. 4Well No. 8 FowlerCompany EngineContractor Maude & T. RogersE. J. Dando NORTH River

WEST

EAST

SOUTH

700 S 200 W

Location _____

Rig up ☒

Drilling and Remarks:

Spudding

RECORD

Cased _____ in., _____ ft.

Sand _____

Gas _____

Oil _____

Total Depth _____

PRODUCTION

1st 24 hrs. Nat. _____

1st 24 hrs. after shot _____

Gas _____ Cu. Ft.

Dry Hole _____

Abandoned _____

Date

10/16 1918 S. C. Conley Scout


Map No. 174 Sec. 1 Twp. 26 R. 4Well No. 83004Company Engineering

Contractor _____

NORTH

WEST

EAST

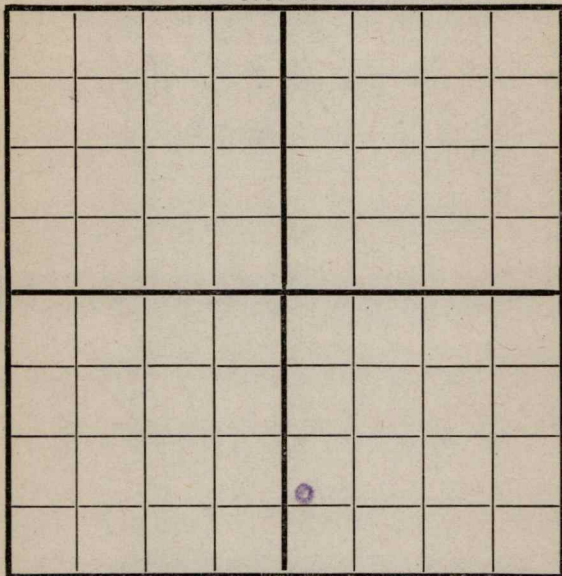

SOUTH

Location 700 S 200th

Rig up _____

Drilling and Remarks:

600

RECORD

Cased _____ in., _____ ft.

Sand _____

Gas _____

Oil _____

Total Depth _____

PRODUCTION

1st 24 hrs. Nat. _____

1st 24 hrs. after shot _____

Gas _____ Cu. Ft.

Dry Hole _____

Abandoned _____

Date


10/23 191 8 Conley Scout

Map No. 1514 Sec. 1 Twp. 26 R. 4
 Well No. 8 Fowler
Empire Company
 Contractor

NORTH

WEST

EAST

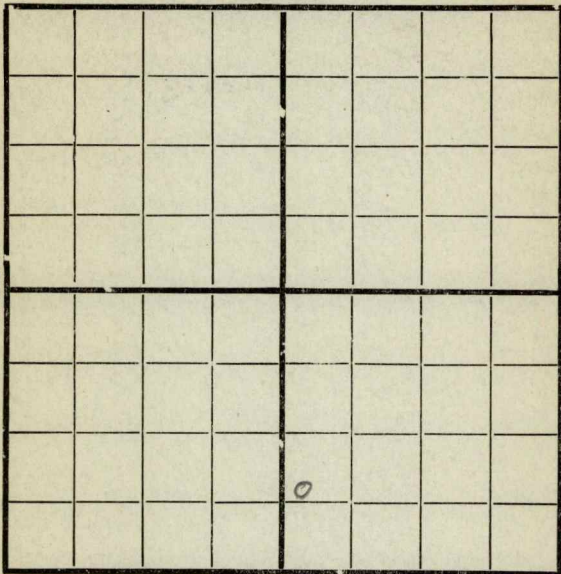

SOUTH

700S-200W

Location _____

Rig up _____

Drilling and Remarks:

950

RECORD

Cased _____ in., _____ ft.

Sand _____

Gas _____

Oil _____

Total Depth _____

PRODUCTION

1st 24 hrs. Nat. _____

1st 24 hrs. after shot _____

Gas _____ Cu. Ft.

Dry Hole _____

Abandoned _____

Date

10/30

191

Scout

Scout


Map No. 1514 Sec. 1 Twp. 26 R. 4Well No. 8 FowlerCompany Engel

Contractor _____

NORTH

WEST

EAST

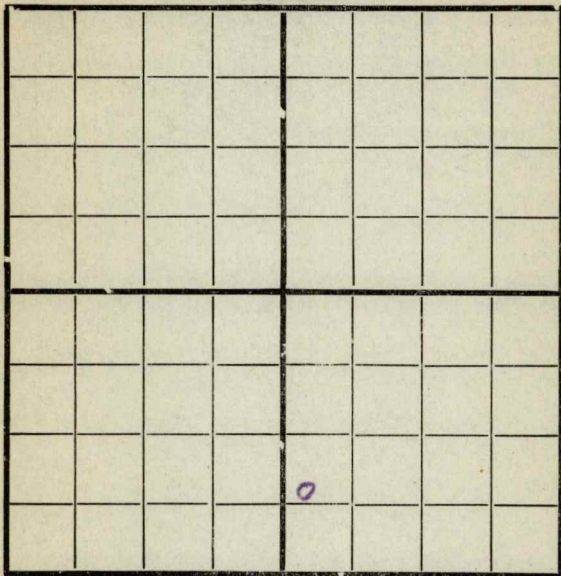

SOUTH

700S-200W

Location _____

Rig up _____

Drilling and Remarks:

1180

RECORD

Cased _____ in., _____ ft.

Sand _____

Gas _____

Oil _____

Total Depth _____

PRODUCTION

1st 24 hrs. Nat. _____

1st 24 hrs. after shot _____

Gas _____ Cu. Ft.

Dry Hole _____

Abandoned _____

Date

11/6 1918 Conley Scout


Map No. K14 Sec. 1 Twp. 26 R. 4

Well No. 8 Fowler
Engine Company _____ Contractor _____

NORTH

WEST

EAST

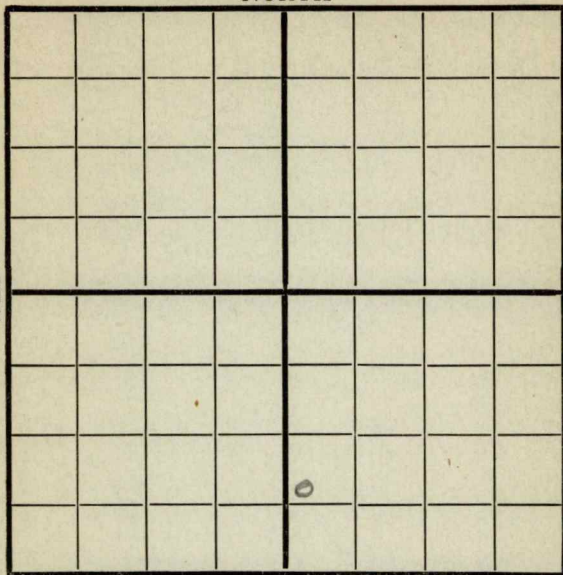

SOUTH

700S-300 W

Location _____

Rig up _____

Drilling and Remarks:

1560

RECORD

Cased _____ in., _____ ft.

Sand _____

Gas _____

Oil _____

Total Depth _____

PRODUCTION

1st 24 hrs. Nat. _____

1st 24 hrs. after shot _____

Gas _____ Cu. Ft.

Dry Hole _____

Abandoned _____

Date

11/13 8 Cordell

Map No. K14 Sec. 26 Twp. 4 R. 4

Well No. 208


Empire Company

Contractor

NORTH

WEST

EAST

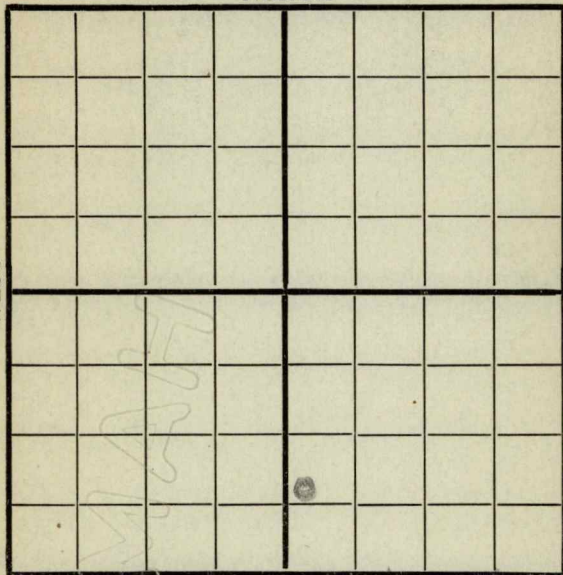

SOUTH

Location

Rig up

Drilling and Remarks:

2080

RECORD

Cased _____ in., _____ ft.

Sand _____

Gas _____

Oil _____

Total Depth _____

PRODUCTION

1st 24 hrs. Nat. _____

1st 24 hrs. after shot _____

Gas _____ Cu. Ft.

Dry Hole _____

Abandoned _____

Date

11/20 J. Condy


Map No. K14 Sec. 1 Twp. 26 R. 4Well No. 8 FowlerEmpire Company

Contractor

NORTH

WEST

EAST

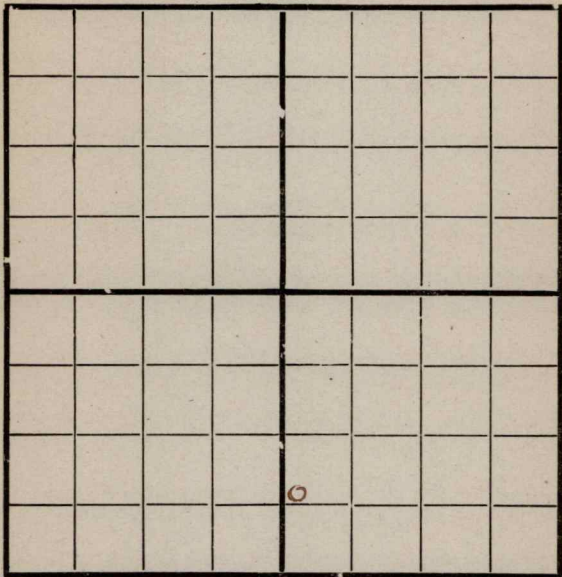

SOUTH

700 S. 200 W

Location _____

Rig up _____

Drilling and Remarks:

2275

RECORD

Cased _____ in., _____ ft.

Sand _____

Gas _____

Oil _____

Total Depth _____

PRODUCTION

1st 24 hrs. Nat. _____

1st 24 hrs. after shot _____

Gas _____ Cu. Ft.

Dry Hole _____

Abandoned _____

Date

11/27 191 5 Cardiff Scout

Map No. K14 Sec. 1 Twp. 26 R. 4Well No. 87Engine Company

Contractor

NORTH

WEST

EAST

SOUTH

700 S-300

Location _____

Rig up _____

Drilling and Remarks:

Tap sand
2443

RECORD

Cased _____ in., _____ ft.

Sand _____

Gas _____

Oil _____

Total Depth _____

PRODUCTION

1st 24 hrs. Nat. _____

1st 24 hrs. after shot _____

Gas _____ Cu. Ft.

Dry Hole _____

Abandoned _____

Date

12/4

191

J. P. C. [Signature]

Scout

Map No. 1514 Sec. 1 Twp. 26 R. 4Well No. 8 FowlerEngine CompanyMamie & Trapp ContractorCP Drivado NORTH Kans

WEST

COMPLETED

EAST

SOUTH

700 S - 200 W

Location _____

Rig up _____

Drilling and Remarks:

Est at
900 Bbls

RECORD

Cased _____ in., _____ ft.

Sand 2443-2505

Gas _____

Oil _____

Total Depth _____

PRODUCTION

1st 24 hrs. Nat. _____

1st 24 hrs. after shot _____

Gas _____ Cu. Ft.

Dry Hole _____

Abandoned _____

Date

12/14 191 8 Condrup Scout