


Map No. _____ Sec. 1 Twp. 26 R. 4Well No. 9 Porter Farm __________Carter Company _____

NORTH

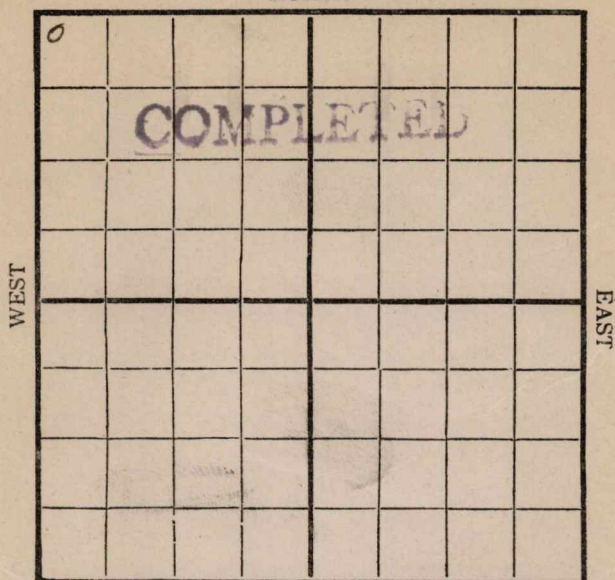

SOUTH

Location _____

Rig Up _____

Drilling Remarks:

Drilling Remarks:

RECORD

Cased _____ in _____ Ft.

Sand _____

Gas _____

Oil _____

Total Depth _____

PRODUCTION

1st 24 hrs. Nat. _____

1st 24 hrs. after shot _____

Gas _____ Cu. Ft.

Dry Hole _____


Abandoned _____

Map No. _____ Sec. 1 Twp. 26 R. 4
 Well No. 9 Porter Farm _____
Carter Company _____

NORTH

WEST

EAST

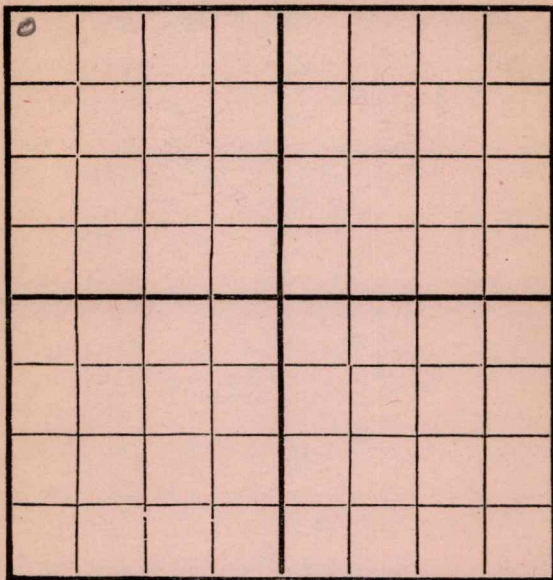

SOUTH

Location ✓
 Rig Up _____
 Drilling and remarks _____

RECORD

Cased _____ in. _____ Ft.
 Sand _____
 Gas _____
 Oil _____
 Total Depth _____

PRODUCTION

1st 24 hrs. Nat. _____
 First 24 hrs. after shot _____
 Gas _____ Cu. Ft.
 Dry Hole _____
 Abandoned _____


FIRST REPORT

Date

9/5, 191 7 Carter Scout

Map No. K14 Sec. 1 Twp. 26 R. 4
 Well No. 9 Porter Farm
Cooper Company

NORTH

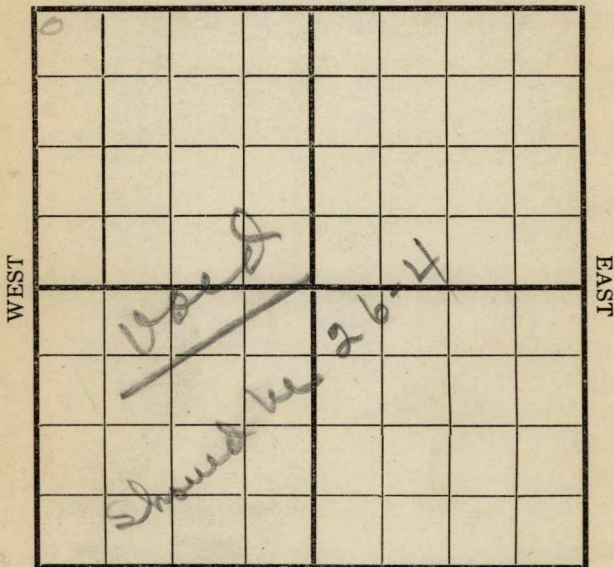

SOUTH

Location _____
 Rig Up _____
 Drilling and remarks _____

RECORD

Cased _____ in. _____ Ft.
 Sand _____
 Gas _____
 Oil _____
 Total Depth _____

PRODUCTION

1st 24 hrs. Nat. _____
 1st 24 hrs. after shot _____
 Gas _____ Cu. Ft.
 Dry Hole _____
 Abandoned _____


Date

2/12, 1912 Cooper Scout

Map No. _____ Sec. 1 Twp. 26 R. 4
 Well No. 9 Porter Farm _____
Carter Company _____

NORTH

WEST

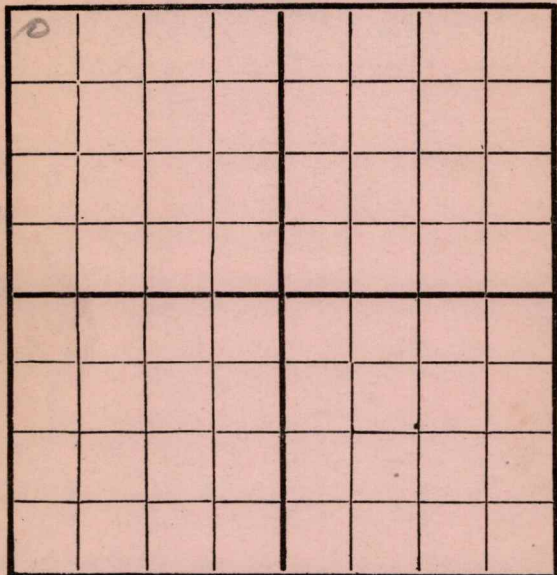

EAST

SOUTH

Location _____
 Rig Up ✓ _____
 Drilling and remarks _____

RECORD

Cased _____ in. _____ Ft.
 Sand _____
 Gas _____
 Oil _____
 Total Depth _____

PRODUCTION

1st 24 hrs. Nat. _____
 1st 24 hrs. after shot _____
 Gas _____ Cu. Ft.
 Dry Hole _____
 Abandoned _____


Date 2/19, 1917 C. Carter Scout

Map No. _____ Sec. 1 Twp. 26 R. 4
 Well No. 9 Porter Farm _____
Carter Company _____

NORTH

WEST

EAST

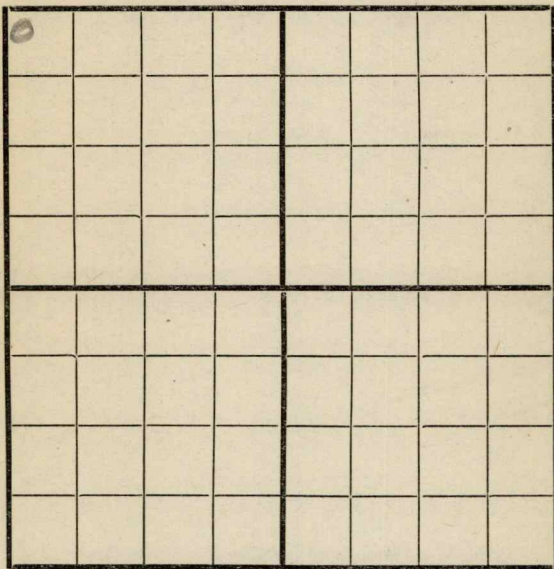

SOUTH

Location _____

Rig Up _____

Drilling and remarks

Open 2 days

RECORD

Cased _____ in. _____ Ft.

Sand _____

Gas _____

Oil _____

Total Depth _____

PRODUCTION

1st 24 hrs. Nat. _____

1st 24 hrs. after shot _____

Gas _____ Cu. Ft.

Dry Hole _____

Abandoned _____

Date

7/26 191 *7* _____ Scout

Map No. _____ Sec. 1 Twp. 26 R. 4
 Well No. 9 Porter Farm _____
Center Company _____

NORTH

WEST									EAST

SOUTH

Location _____
 Rig Up _____
 Drilling and remarks _____

600'

RECORD


Cased _____ in. _____ Ft.
 Sand _____
 Gas _____
 Oil _____
 Total Depth _____

PRODUCTION

1st 24 hrs. Nat. _____
 1st 24 hrs. after shot _____
 Gas _____ Cu. Ft.
 Dry Hole _____
 Abandoned _____

Date

3/5, 191 7 Cardiff Scout

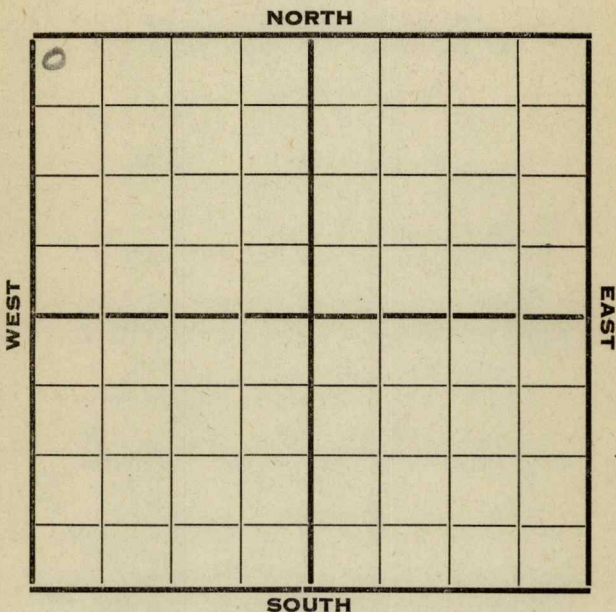Map No. Sec. 1 Twp. 26 R. 4Well No. 9 Porter Farm
Carter Company

Location

Rig up

Drilling and Remarks:

740**RECORD**

Cased in. Ft.

Sand

Gas

Oil

Total Depth

PRODUCTION

1st 24 hrs. Nat.

1st 24 hrs. after shot

Gas Cu. Ft.

Dry Hole

Abandoned

Date

3/12, 1917, Carter Scout

Map No. _____ Sec. 1 Twp. 26 R. 4
 Well No. 9 Porter Farm _____
Carter Company _____

NORTH

WEST	<u>0</u>								EAST

SOUTH

Location _____
 Rig Up _____
 Drilling and remarks _____

*Shut
 Down
 740*

RECORD

Cased _____ in. _____ Ft.
 Sand _____
 Gas _____
 Oil _____
 Total Depth _____

PRODUCTION


1st 24 hrs. Nat. _____
 1st 24 hrs. after shot _____
 Gas _____ Cu. Ft.
 Dry Hole _____
 Abandoned _____

Date

3/21, 1912 Carter Scout

Map No. _____ Sec. 1 Twp. 26 R. 4Well No. 9 Porter Farm
Conter Company

NORTH

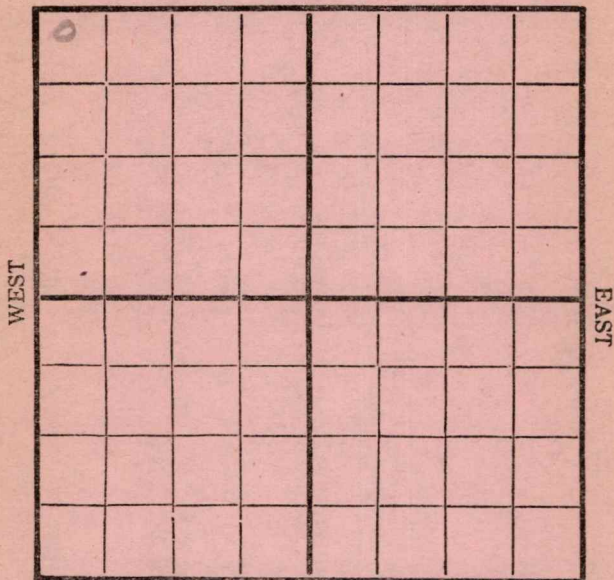

SOUTH

REMARKS:

1490


Date

3/26, 1912 Conter Scout

Map No. _____ Sec. 1 Twp. 26 R. 4Well No. 9 Porter Farm __________

Company _____

NORTH

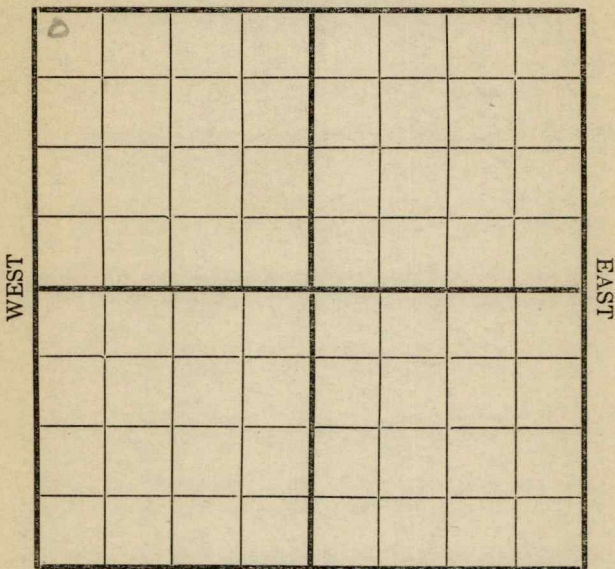

SOUTH

Location _____

Rig Up _____

Drilling and remarks

1540'

RECORD

Cased _____ in. _____ Ft.

Sand _____

Gas _____

Oil _____

Total Depth _____

PRODUCTION

1st 24 hrs. Nat. _____

1st 24 hrs. after shot _____

Gas _____ Cu. Ft.

Dry Hole _____

Abandoned _____

Date

4/5, 1917 Carly Scout

Map No. _____ Sec. 1 Twp. 26 R. 4Well No. 9 Porter _____ FarmCarter _____ Company

NORTH

WEST

EAST

SOUTH

Location _____

Rig Up _____

Drilling and remarks

Shut
Down
1540'

RECORD

Cased _____ in. _____ Ft.

Sand _____

Gas _____

Oil _____

Total Depth _____

PRODUCTION

1st 24 hrs. Nat. _____

1st 24 hrs. after shot _____

Gas _____ Cu. Ft.

Dry Hole _____

Abandoned _____

Date

4/11, 1917 Carter Scout

Map No. _____ Sec. 1 Twp. 26 R. 4
 Well No. 9 Porter Farm _____
Porter Company _____

NORTH

WEST	0								EAST

SOUTH

Location _____
 Rig Up _____
 Drilling and remarks _____

1825'

RECORD

Cased _____ in. _____ Ft.
 Sand _____
 Gas _____
 Oil _____
 Total Depth _____


PRODUCTION

1st 24 hrs. Nat. _____
 1st 24 hrs. after shot _____
 Gas _____ Cu. Ft.
 Dry Hole _____
 Abandoned _____

Date 4/19, 1912 Porter Scout

Map No. _____ Sec. 1 Twp. 26 R. 4
 Well No. 9 Porter Farm _____
Center Company _____

NORTH

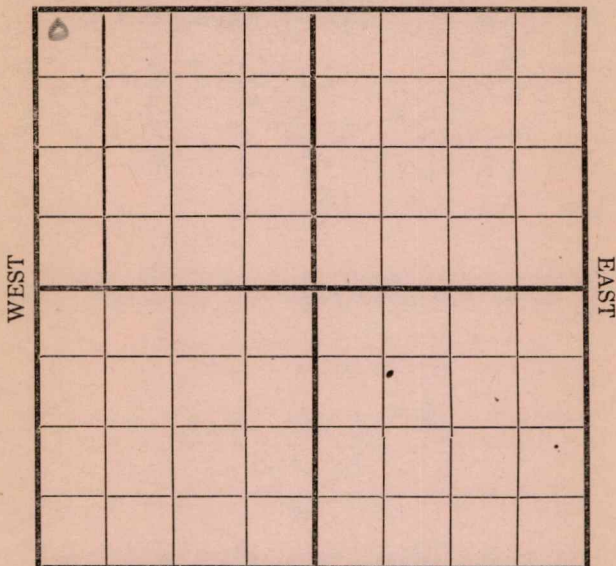

SOUTH

Location _____
 Rig Up _____
 Drilling and remarks

2085

RECORD

Cased _____ in. _____ Ft.
 Sand _____
 Gas _____
 Oil _____
 Total Depth _____

PRODUCTION

1st 24 hrs. Nat. _____
 1st 24 hrs. after shot _____
 Gas _____ Cu. Ft.
 Dry Hole _____
 Abandoned _____

Date

4/26, 1917 Carly Scout

Map No. _____ Sec. 1 Twp. 26 R. 4

Well No. 9 Porter Farm _____

Carter Company _____

NORTH

WEST	<u>0</u>								EAST

SOUTH

Location _____

Rig up _____

Drilling and remarks:

D-2330

RECORD

Cased _____ in. _____ Ft.

Sand _____

Gas _____

Oil _____

Total Depth _____

PRODUCTION

1st 24 hrs. Nat. _____

1st 24 hrs. after shot _____

Gas _____ Cu. Ft.


Dry Hole _____

Abandoned _____

Date

5/5, 1917, Crocker Scout

Map No. _____ Sec. 1 Twp. 26 R. 4
 Well No. 9 Porter Farm _____
Carter Company _____
 NORTH

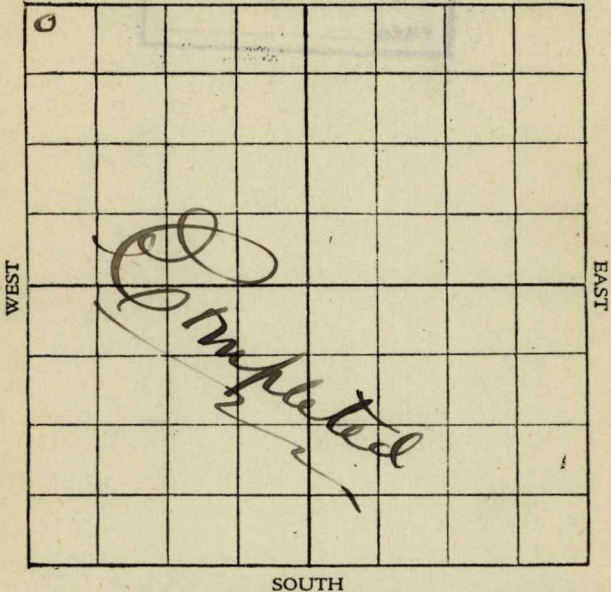

SOUTH

Location _____
 Rig up _____
 Drilling and remarks:

RECORD

Cased _____ in. _____ Ft.
 Sand _____
 Gas _____
 Oil 2447-2460
 Total Depth 2460

PRODUCTION

1st 24 hrs. Nat. _____
 1st 24 hrs. after shot _____
 Gas _____ Cu. Ft.
 Dry Hole _____
 Abandoned _____

JS. 2447
Filled up in
10 hrs. run over
Est. 200 bbls

Date

5712, 1917, Crocker Scout