


Map No. _____ Sec. 1 Twp. 26 R. 4
 Well No. 19-Porter Farm _____
Carter Company _____

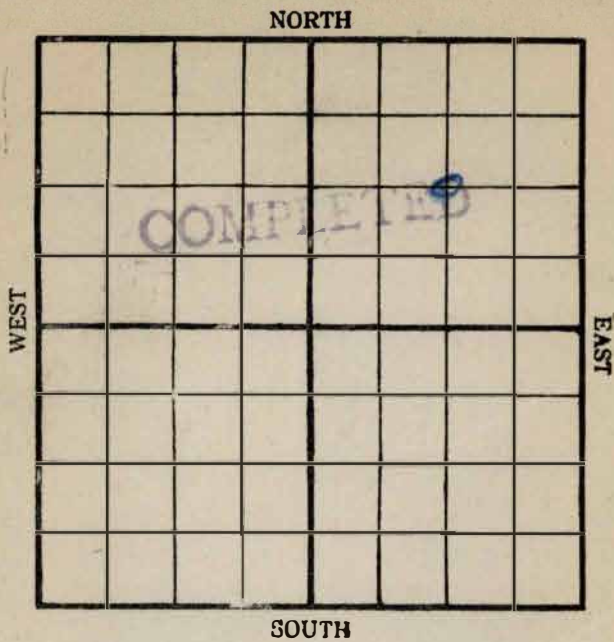

Location _____

Rig Up _____

Drilling Remarks:

Drilling Remarks:

RECORD

PRODUCTION

Cased _____ in. _____ ft.
 Sand _____
 Gas _____
 Oil _____
 Total Depth _____


1st 24 hrs. Nat. _____
 1st 24 hrs. after shot _____
 Gas _____ c
 Dry Hole _____
 Abandoned _____

Map No. K-14 Sec. 1 Twp. 26 R. 4
 Well No. 19. Foster Farm
Coster Company

NORTH

WEST

EAST

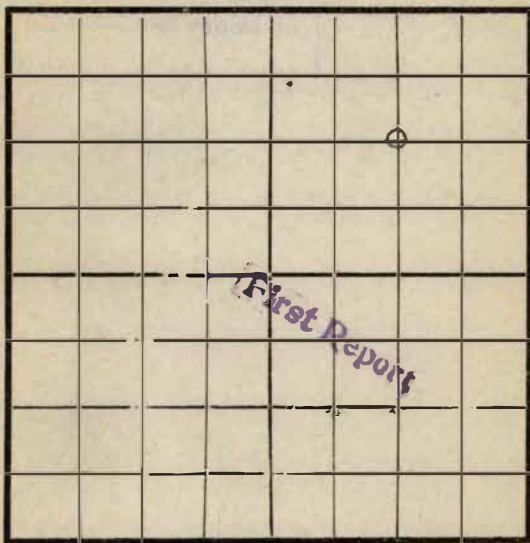

SOUTH

Location _____
 Rig Up ☒ _____
 Drilling and remarks _____

RECORD

Cased _____ in. _____ Ft.
 Sand _____
 Gas _____
 Oil _____
 Total Depth _____

PRODUCTION

1st 24 hrs. Nat. _____
 1st 24 hrs. after shot _____
 Gas _____ Cu. Ft.
 Dry Hole _____
 Abandoned _____

Date

8-23, 1917 Lauzy Scout

Map No. _____ Sec. 1 Twp. 26 R. 4


Well No. 19 Porter Farm _____

Porter Company _____

NORTH

WEST

EAST

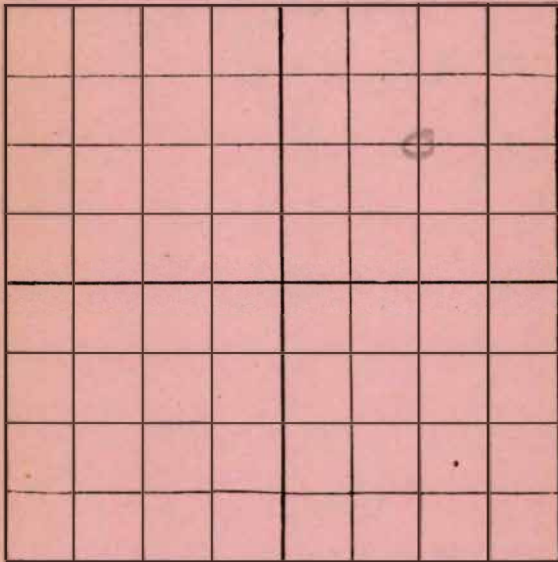

SOUTH

Location _____

Rig up _____

Drilling and remarks:

1330

RECORD

Cased _____ in. _____ Ft.

Sand _____

Gas _____

Oil _____

Total Depth _____

PRODUCTION

1st 24 hrs. Nat. _____

1st 24 hrs. after shot _____

Gas _____ Cu. Ft.

Dry Hole _____

Abandoned _____

Date


10/9, 1917, Condyff Scout

Map No. _____ Sec. 1 Twp. 26 R. 4

Well No. 19 Porter Farm _____
Porter Company _____

NORTH

WEST

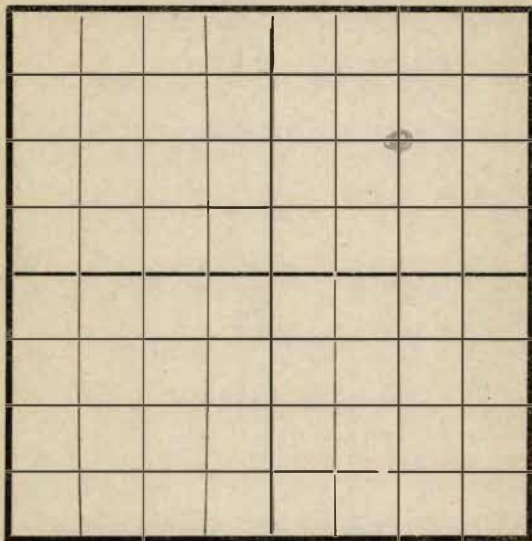

EAST

SOUTH

Location _____

Rig Up _____

Drilling and remarks

1445

RECORD

Cased _____ in _____ Ft.

Sand _____

Gas _____

Oil _____

Total Depth _____

PRODUCTION

1st 24 hrs. Nat. _____

1st 24 hrs. after shot _____

Gas _____ Cu. Ft.

Dry Hole _____

Abandoned _____


Date

1917, 1917 Carley Scout

Map No. _____ Sec. 1 Twp. 26 R. 4
 Well No. 19 Porter Farm _____
Porter Company _____

NORTH

WEST

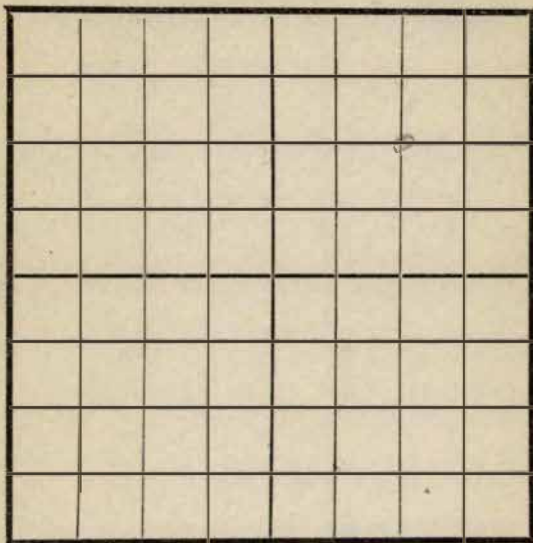

EAST

SOUTH

Location _____
 Rig Up _____
 Drilling and remarks

1630

RECORD

Cased _____ in. _____ Ft.
 Sand _____
 Gas _____
 Oil _____
 Total Depth _____

PRODUCTION

1st 24 hrs. Nat. _____
 1st 24 hrs. after shot _____
 Gas _____ Cu. Ft.
 Dry Hole _____
 Abandoned _____

Date

10/24, 1917 Carroll Scout

Map No. _____ Sec. 1 Twp. 26 R. 4Well No. 19 Porter Farm __________
Company _____

NORTH

WEST

EAST

SOUTH

Location _____

Rig Up _____

Drilling and remarks

RECORD

Cased _____ in. _____ Ft.

Sand _____

Gas _____

Oil _____

Total Depth _____

PRODUCTION

1st 24 hrs. Nat. _____

1st 24 hrs. after shot _____

Gas _____ Cu. Ft.

Dry Hole _____

Abandoned _____


Date

10/31, 1912 Co. D. J. Scout _____

Map No. _____ Sec. 1 Twp. 26 R. 4Well No. 19 Porter Farm _____
Center Company _____

NORTH

WEST

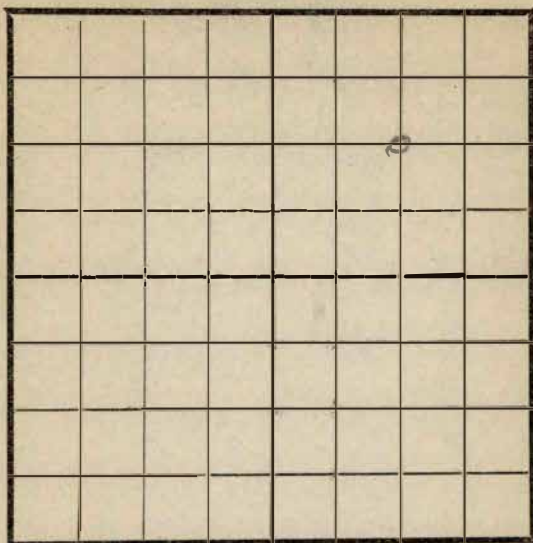

EAST

SOUTH

Location _____

Rig Up _____

Drilling and remarks

2075

RECORD

Cased _____ in. _____ Ft.

Sand _____

Gas _____

Oil _____

Total Depth _____

PRODUCTION.

1st 24 hrs. Nat. _____

1st 24 hrs. after shot _____

Gas _____ Cu. Ft.

Dry Hole _____

Abandoned _____


Date

11-7, 1917 Carroll Scout _____

Map No. _____ Sec. 1 Twp. 26 R. 4
 Well No. 19 Porter Farm _____
Center Company _____

NORTH

WEST

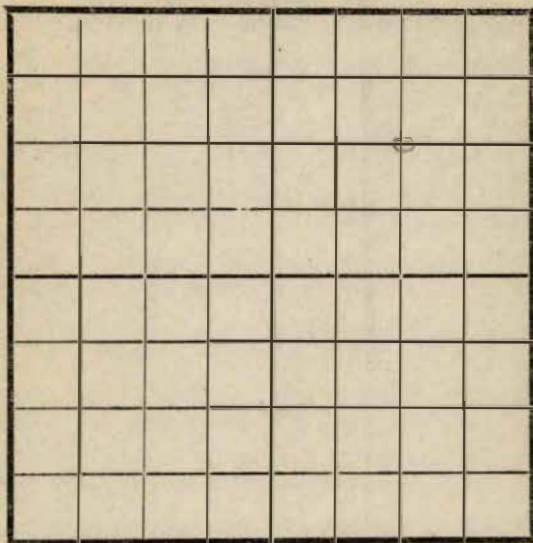

EAST

SOUTH

Location _____
 Rig Up _____
 Drilling and remarks

2268

RECORD

Cased _____ in _____ Ft.
 Sand _____
 Gas _____
 Oil _____
 Total Depth _____

PRODUCTION

1st 24 hrs. Nat. _____
 1st 24 hrs. after shot _____
 Gas _____ Cu. Ft.
 Dry Hole _____
 Abandoned _____


Date

11/14, 1917 Condy Scout

Map No. _____ Sec. 1 Twp. 26 R. 4
 Well No. 19 Poodu Farm _____
Miller Company

NORTH

WEST

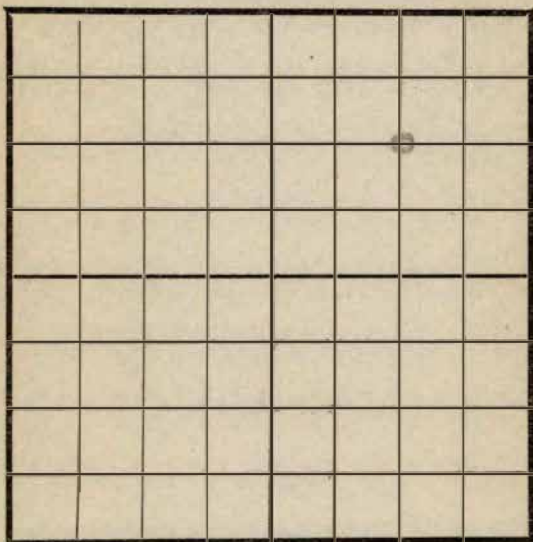

EAST

SOUTH

Location _____
 Rig Up _____
 Drilling and remarks

2409

RECORD

Cased _____ in. _____ Ft.
 Sand _____
 Gas _____
 Oil _____
 Total Depth _____

PRODUCTION

1st 24 hrs. Nat. _____
 1st 24 hrs. after shot _____
 Gas _____ Cu. Ft.
 Dry Hole _____
 Abandoned _____


Date

11/21, 1917 Carney Scout

Map No. K14 Sec. 1 Twp. 26 R. 4
 Well No. 19 Porter Farm
Porter Company

NORTH

WEST

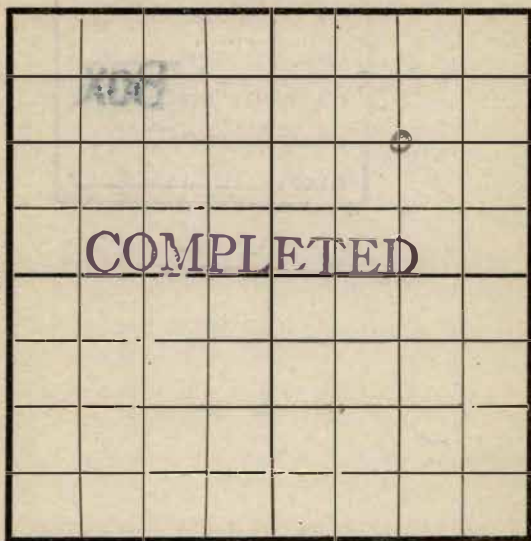

EAST

SOUTH

Location -----

Rig Up -----

Drilling and remarks

Est at185 Bbls

RECORD

Cased ----- in. ----- Ft.

Sand 2410 - 2472

Gas -----

Oil -----

Total Depth -----

PRODUCTION

1st 24 hrs. Nat. -----

1st 24 hrs. after shot -----

Gas ----- Cu. Ft.

Dry Hole -----

Abandoned -----

Date

12/5, 1917 Porter Scout