

Map No. _____ Sec. 1 Twp. 26 R. 4


Well No. 22. Porter Farm _____

Carter Company _____

NORTH

WEST

EAST

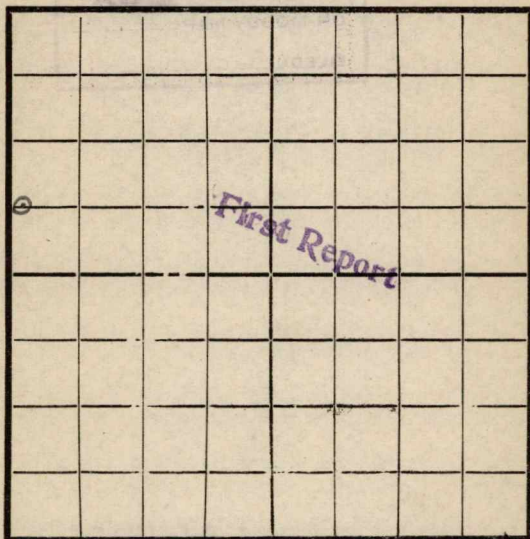

SOUTH

Location _____

Rig Up ☒ _____

Drilling and remarks _____

RECORD

Cased _____ in. _____ Ft.

Sand _____

Gas _____

Oil _____

Total Depth _____

PRODUCTION

1st 24 hrs. Nat. _____

1st 24 hrs. after shot _____

Gas _____ Cu. Ft.

Dry Hole _____

Abandoned _____

Date

8-23, 1917


Lantz

Scout

Map No. _____ Sec. 1 Twp. 26 R. 4

Well No. 22 Porter Farm _____
Porter Company _____

NORTH

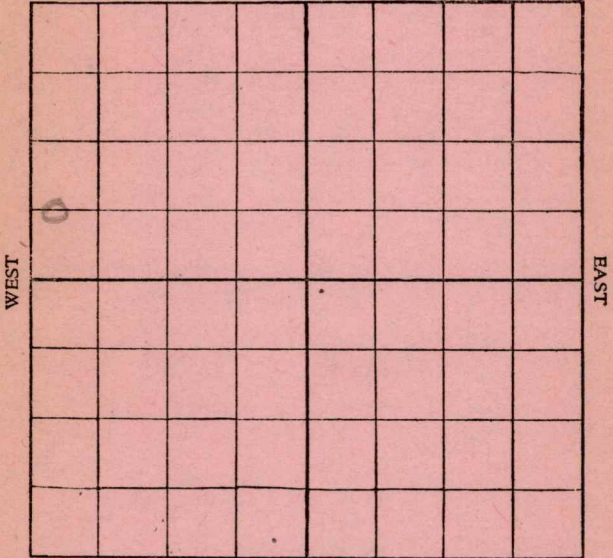

SOUTH

Location _____
Rig up _____
Drilling and remarks:

975

RECORD

Cased _____ in. _____ Ft.
Sand _____
Gas _____
Oil _____
Total Depth _____

PRODUCTION

1st 24 hrs. Nat. _____
1st 24 hrs. after shot _____
Gas _____ Cu. Ft.
Dry Hole _____
Abandoned _____


Date _____
10/9, 1917, Carbide Scout

Map No. _____ Sec. 1 Twp. 26 R. 4

Well No. 22 Porter Farm _____
Porter Company _____

NORTH

WEST

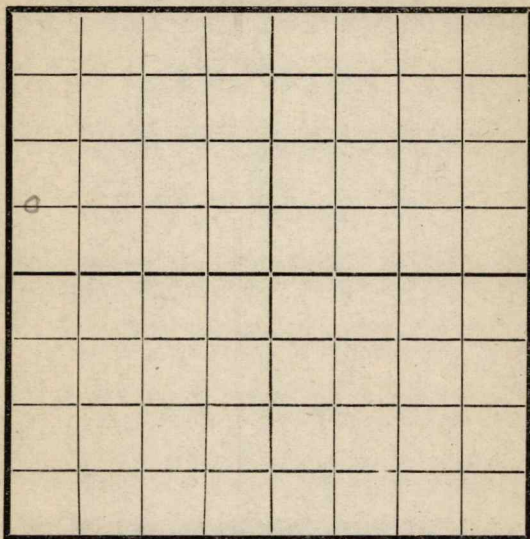

EAST

SOUTH

Location _____

Rig Up _____

Drilling and remarks

1160

RECORD

Cased _____ in _____ Ft.

Sand _____

Gas _____

Oil _____

Total Depth _____

PRODUCTION

1st 24 hrs. Nat. _____

1st 24 hrs. after shot _____

Gas _____ Cu. Ft.

Dry Hole _____

Abandoned _____

Date


10/17, 1917 Carroll Scout

Map No. _____ Sec. 1 Twp. 26 R. 4

Well No. 22 Porter Far _____
Carter Compan _____

NORTH

WEST

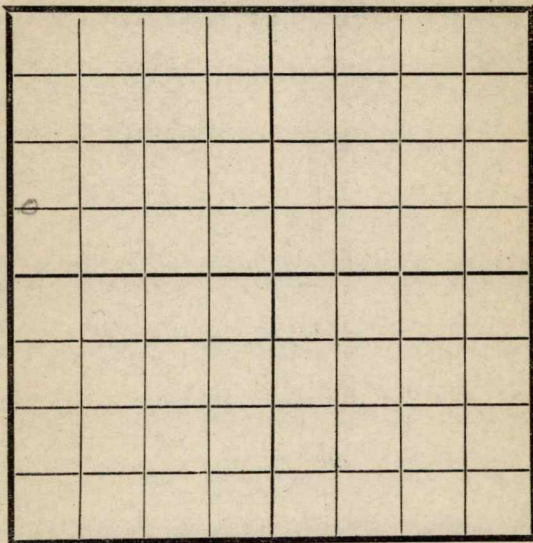

EAST

SOUTH

Location _____

Rig Up _____

Drilling and remarks

2235

RECORD

Cased _____ in. _____ Ft.

Sand _____

Gas _____

Oil _____

Total Depth _____

PRODUCTION

1st 24 hrs. Nat. _____

1st 24 hrs. after shot _____

Gas _____ Cu. Ft.

Dry Hole _____

Abandoned _____

Date

10/24, 1917


C. J. Carter

Scout

Map No. _____ Sec. 1 Twp. 26 R. 4
 Well No. 22 Porter Farm _____
Carter Company _____

NORTH

WEST

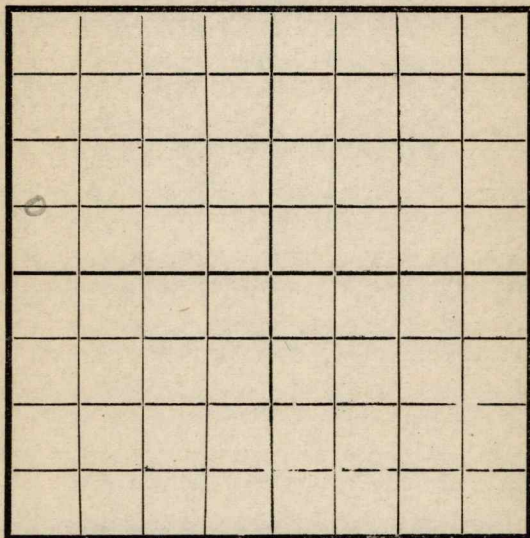

EAST

SOUTH

Location _____

Rig Up _____

Drilling and remarks

22

2235

RECORD

Cased _____ in _____ Ft.

Sand _____

Gas _____

Oil _____

Total Depth _____

PRODUCTION

1st 24 hrs. Nat. _____

1st 24 hrs. after shot _____

Gas _____ Cu. Ft.

Dry Hole _____

Abandoned _____


Date

10/31, 191*9*, *Carter* Scout

Map No. _____ Sec. 1 Twp. 26 R. 4Well No. 22 Porter Farm _____Porter Company _____

NORTH

WEST

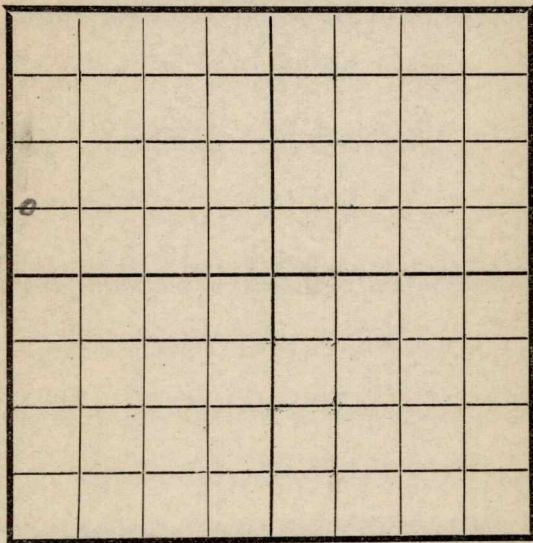

EAST

SOUTH

Location _____

Rig Up _____

Drilling and remarks

22225

RECORD

Cased _____ in. _____ Ft.

Sand _____

Gas _____

Oil _____

Total Depth _____

PRODUCTION

1st 24 hrs. Nat. _____

1st 24 hrs. after shot _____

Gas _____ Cu. Ft.

Dry Hole _____

Abandoned _____

Date


11-7, 1917 Conley Scout _____

Map No. _____ Sec. 1 Twp. 26 R. 4
 Well No. 22 Porter Farm _____
Carter Company _____

NORTH

WEST

EAST

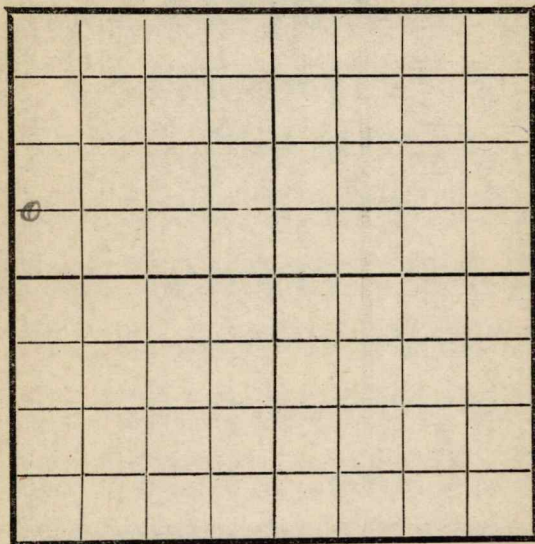

SOUTH

Location _____
 Rig Up _____
 Drilling and remarks _____

SD 2235

RECORD

Cased _____ in. _____ Ft.
 Sand _____
 Gas _____
 Oil _____
 Total Depth _____

PRODUCTION

1st 24 hrs. Nat. _____
 1st 24 hrs. after shot _____
 Gas _____ Cu. Ft.
 Dry Hole _____
 Abandoned _____


Date

11/14, 1917 C. Carter Scout _____

Map No. _____ Sec. 1 Twp. 26 R. 4Well No. 22 Porter Farm
Porter Company

NORTH

WEST

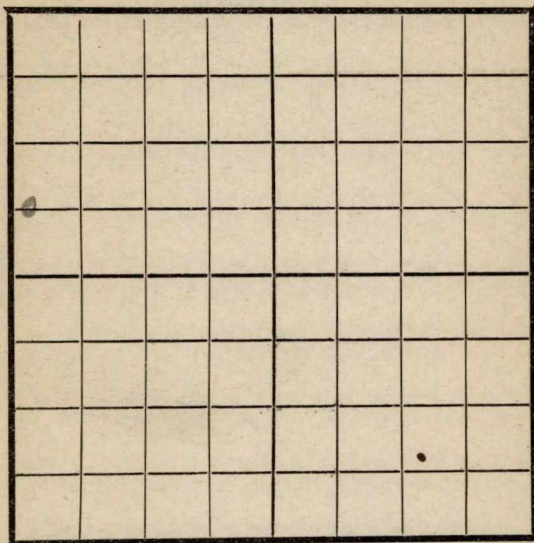

EAST

SOUTH

Location _____

Rig Up _____

Drilling and remarks

222235

RECORD

Cased _____ in. _____ Ft.

Sand _____

Gas _____

Oil _____

Total Depth _____

PRODUCTION

1st 24 hrs. Nat. _____

1st 24 hrs. after shot _____

Gas _____ Cu. Ft.

Dry Hole _____

Abandoned _____


Date

11/21, 1917 Carby Scout

Map No. _____ Sec. 1 Twp. 26 R. 4Well No. 22 Porter Farm __________Carter Company

NORTH

WEST

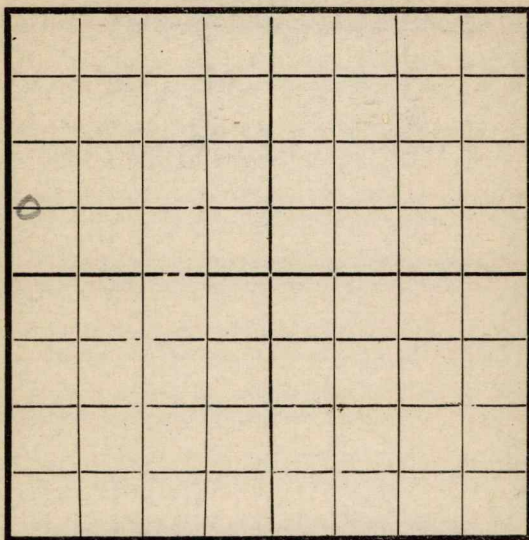

EAST

SOUTH

Location _____

Rig Up _____

Drilling and remarks

2204

RECORD

Cased _____ in. _____ Ft.

Sand _____

Gas _____

Oil _____

Total Depth _____

PRODUCTION

1st 24 hrs. Nat. _____

1st 24 hrs. after shot _____

Gas _____ Cu. Ft.

Dry Hole _____

Abandoned _____

Date


12/5, 1917 Carter Scout

Map No. _____ Sec. 1 Twp. 26 R. 4Well No. 22 Porter Farm _____

Company _____

NORTH

WEST

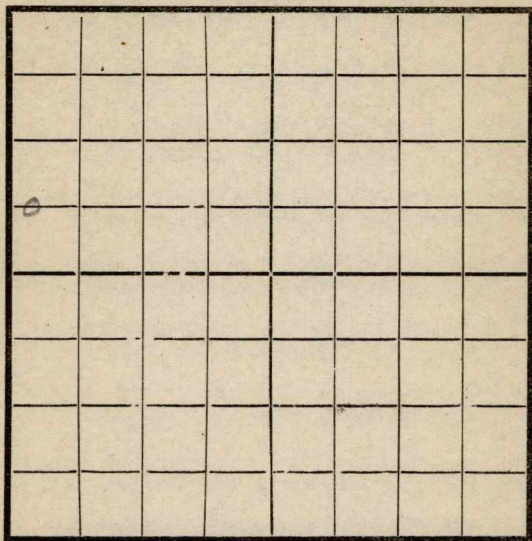

EAST

SOUTH

Location _____

Rig Up _____

Drilling and remarks

2445

RECORD

Cased _____ in. _____ Ft.

Sand _____

Gas _____

Oil _____

Total Depth _____

PRODUCTION

1st 24 hrs. Nat. _____

1st 24 hrs. after shot _____

Gas _____ Cu. Ft.


Dry Hole _____

Abandoned _____

Date

1/2, 1918 C. C. Cady Scout

Map No. _____ Sec. 1 Twp. 26 R. 4
 Well No. 22 Porter Farm _____
Carter Company _____

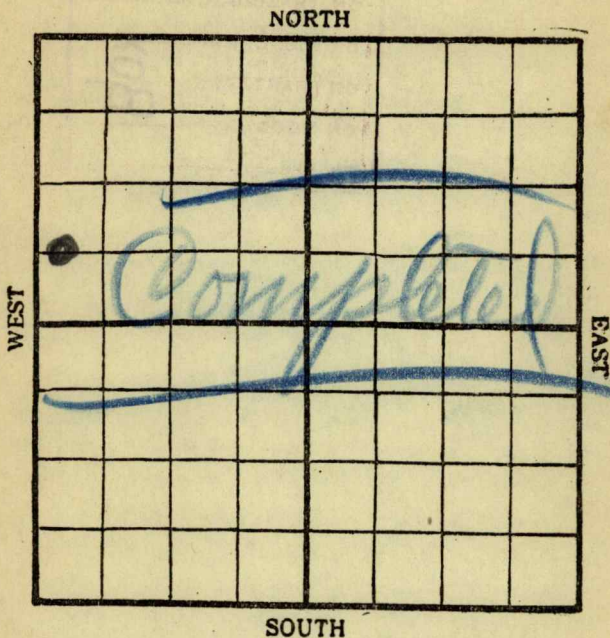

Location _____

Rig Up _____

Drilling and remarks

*Estimated
600 Bbls*

RECORD

Cased _____ in. _____ Ft.

Sand 2385-2442

Gas _____

Oil _____

Total Depth _____

PRODUCTION

1st 24 hrs. Nat. _____

1st 24 hrs. after shot _____

Gas _____ Cu. Ft.

Dry Hole _____

Abandoned _____

Date

1/16, 1918, P. Candy Scout